

Hancock  
 C 2024  
 6-68

MISSISSIPPI  
 BOARD OF WATER COMMISSIONERS  
 416 North State Street  
 Jackson, Mississippi 39201

WATER WELL DRILLERS LOG

6-14 1968 Penton Well Serv Hancock  
 date well completed firm name county well located

LANDOWNER: Fred Boudis

description of formations encountered	from	to
	<u>Red clay</u>	<u>0</u>
<u>White clay</u>	<u>18</u>	<u>26</u>
<u>Red clay</u>	<u>26</u>	<u>40</u>
<u>Sand</u>	<u>40</u>	<u>68</u>

Rt. 1 - Box 269  
Picayune Miss  
 (mailing address)

WELL LOCATION:

sec. 33 T. 6 S. R. 16 W.  
5 miles East of Picayune  
 (distance) (direction) (nearest town)

WELL PURPOSE: Home  
 (home, irrigation, municipal, industrial)

WELL COMPLETION DATA:

- (1) diameter (inches) 2"
- (2) total depth (feet) 68
- (3) static water level (feet) 30 below top of ground.
- (4) casing Galv. S., 63,  
 (material) (depth)  
2"  
 (size) if telescope see back.
- (5) screen 5', 63  
 (length) (depth to top)
- .012 2", S. Steel  
 (size) (material)
- (6) pump    
 (HP) (yield gpm)  
  
 (type power)
- (7) electric log NO.  
 (yes or no)

(organization running log)

(8) how well bottom plugged Bw. Valve


DRILLERS REMARKS:

NO Pump installed

JUN 18 1968  
 MISS. DIV. OF  
 WATER CONTROL

If well telescopes please sketch and show depths.

GROUND LEVEL

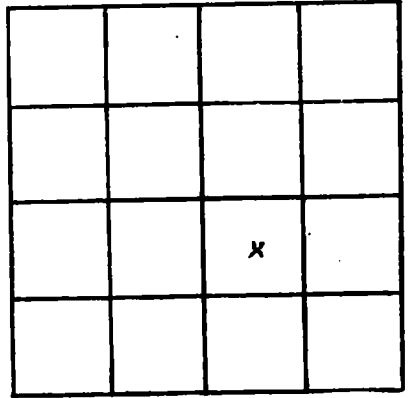

SECTION 25

Please indicate well location X.

ADDITIONAL INFORMATION

If more than one screen,  
show locations of each on sketch.