

Hancock
 C. 2025
 7-68

MISSISSIPPI
 BOARD OF WATER COMMISSIONERS
 416 North State Street
 Jackson, Mississippi 39201

WATER WELL DRILLERS LOG


7-23 date well completed 1968 Penton Well Serv firm name Hancock county well located

LANDOWNER: Earlie Taylor
Rt. 3 Box 310
Picayune MISS
 (mailing address)
 WELL LOCATION:
 sec. 34 T. 6 S. R. 15 W.
5 1/2 miles NW of Kiln
 (distance) (direction) (nearest town)

description of formations encountered	From	To
Clay	0	38
Sand	38	55
White Clay	55	80
Brown Clay	80	112
Blue Clay	112	338
Grey Sand	338	387

WELL PURPOSE: Home
 (home, irrigation, municipal, industrial)

- WELL COMPLETION DATA:
- diameter (inches) 2"
 - total depth (feet) 387'
 - static water level (feet) 8 below top of ground.
 - casing Galv. Steel 382'
 (material) (depth)
2" if telescope see back.
 (size)
 - screen 5' 382'
 (length) (depth to top)
2" S. Steel
 (size) (material)
 - pump 1 11
 (HP) (yield gpm)
Elec
 (type power)
 - electric log NO
 (yes or no)
 (organization running log)
 - how well bottom plugged BW. Valve

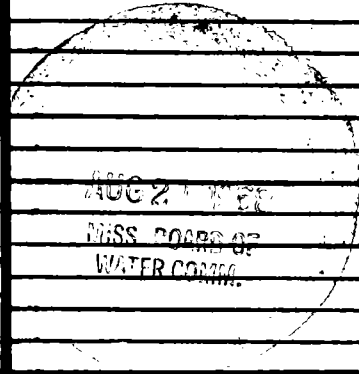

DRILLERS REMARKS:

