

HANCOCK
C 2031
10-14-77

MISSISSIPPI
 BOARD OF WATER COMMISSIONERS
 416 North State Street
 Jackson, Mississippi 39201

138

WATER WELL DRILLERS LOG

10-14-77 date well completed Penton Well Serv firm name HANCOCK county well located

LANDOWNER: Rose LAONER
RF.
Picayune, ms.
 (mailing address)
 WELL LOCATION:
 sec 22 T 6 S R 16 W
7 miles East of Picayune
 (distance) (direction) (nearest town)

description of fomations encountered	from	to
CLAY	0	60
SANDY GRAVEL	60	75
Blue CLAY	75	590
SAND	590	654

WELL PURPOSE: Home
 (home, irrigation, municipal, industrial)

WELL COMPLETION DATA:
 (1) diameter (inches) 2"
 (2) total depth (feet) 654'
 (3) static water level (feet) 4' below above top of ground.
 (4) casing GALV. 644'
 (material) (depth)
2" if telescope see back.
 (size)
 (5) screen 10' 644'
 (length) (depth to top)
2" S. Steel
 (size) (material)
 (6) pump 1 11
 (HP) (yield gpm)
Elec
 (type power)
 (7) electric log NO
 (yes or no)
 (organization running log)
 (8) how well bottom plugged B.W. DAVE


DRILLERS REMARKS:

RECEIVED
 NOV - 4 1977

MISS. BD. OF WATER COMM

If well telescopes please sketch and show depths.

GROUND LEVEL

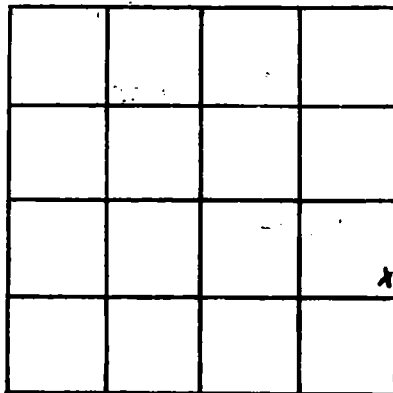

SECTION 22

Please indicate well location X.

ADDITIONAL INFORMATION

If more than one screen, show locations of each on sketch.