

HANCOCK

C 2034

MISSISSIPPI BOARD OF WATER COMMISSIONERS
416 North State Street
Jackson, Mississippi 39201

WATER WELL DRILLERS LOG

4-6 date well completed

firm name

county well located

1978 Pouncey Water Drilling

Hancock

LANDOWNER: Gene Morant

Rt. 3 P. O. Box 105

Lebanon

(mailing address)

description of formations encountered

from

to

WELL LOCATION:

sect 17 T 6 N R 15 E

12 miles E of P. O. Box

WELL PURPOSE: Home (home, irrigation, municipal, industrial)

WELL COMPLETION DATA:

- (1) diameter (inches) 2
- (2) total depth (feet) 392
- (3) static water level (feet) 22 below top of ground
- (4) casing 2 (size) 382 (depth) (material) galv.
- (5) screen 2 (size) 382 (length) (depth to top) stainless steel
- (6) pump 12 (HP) (yield gpm) AC-770 (type power)
- (7) electric log (yes or no)
- (8) how well bottom plugged sealed

| | | |
|---------------|-----|-----|
| Top | 0 | 16 |
| Sd. | 16 | 60 |
| Clay | 60 | 90 |
| Sd. Fine | 90 | 100 |
| Clay | 100 | 135 |
| Sd. | 135 | 145 |
| Clay | 145 | 160 |
| Hd. clay | 160 | 192 |
| Sd. Fine | 192 | 203 |
| Clay | 203 | 288 |
| Sd. Fine fine | 288 | 375 |
| Sd. Hard | 375 | 392 |

DRILLERS REMARKS: Good well


RECEIVED

AUG - 1 1978

MISS. BD. OF WATER COMM.

If well telescopes please sketch and show depths.

GROUND LEVEL

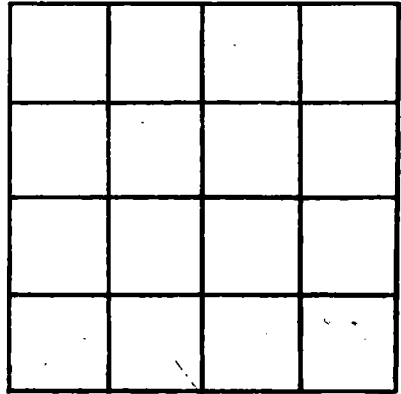

SECTION _____

Please indicate well location X.

ADDITIONAL INFORMATION

If more than one screen, show locations of each on sketch.