

HANCOCK

C 2041

7/29/80

729

MISSISSIPPI BOARD OF WATER COMMISSIONERS
416 North State Street
Jackson, Mississippi 39201

WATER WELL DRILLERS LOG

WINCEY WATER WELL DRILLING

HANCOCK

date well completed

firm name

county well located

LANDOWNER:

T.B. Patterson

description of formations encountered

from

to

Pf 3

Picayune, ms -
(mailing address)

Top
Slt

0 12
12 40

WELL LOCATION:

sec. 17 T 6 N R 15 E
11 miles E of Picayune
(distance) (direction) (nearest town)

junk
D cut - sct.

40 90
90 122

WELL PURPOSE:

(home, irrigation, municipal, industrial)

Home

Clay some silt
junk silt
Slt fine, fine

122 375
375 408

WELL COMPLETION DATA:

- (1) diameter (inches) 4 1/2
- (2) total depth (feet) 408
- (3) static water level (feet) 30 below top of ground.

(4) casing PVC 398
(material) (depth)

(size) If telescope see back.

(5) screen 10 398
(length) (depth to top)

2 PVC
(size) (material)

(6) pump 3/4 20
(HP) (yield gpm)

220V AC
(type power)

(7) electric log (yes or no)

(organization running log)

(8) how well bottom plugged Silt

DEPT. OF NATURAL RESOURCES
BUREAU OF LAND & WATER RESOURCES



AUG 11 1980

RECEIVED

DRILLERS REMARKS:

If well telescopes please sketch and show depths.

GROUND LEVEL

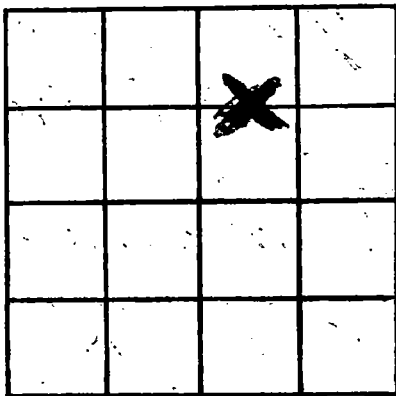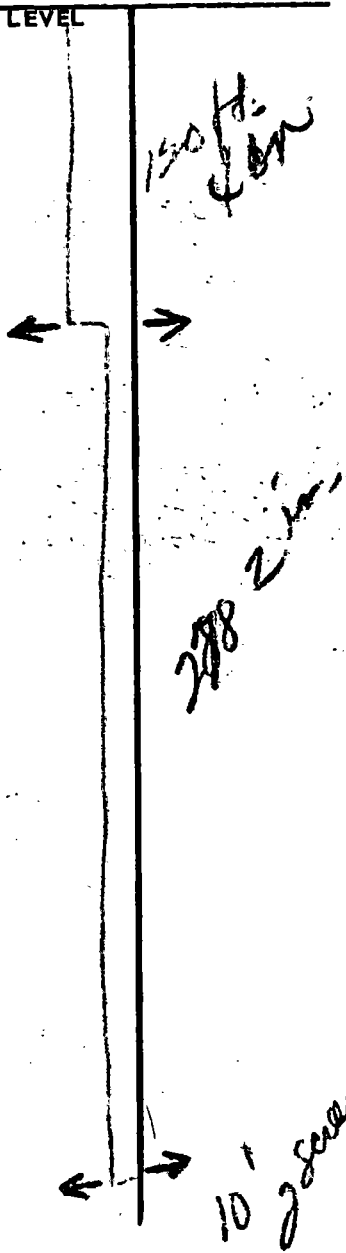

SECTION 17

Please indicate well location X.

ADDITIONAL INFORMATION

Have 2" well at
4 miles don't know
depth or drill
4x2 New for Duplex

If more than one screen, show locations of each on sketch.