

MISSISSIPPI DEPARTMENT OF NATURAL RESOURCES

Bureau of Land and Water Resources

Southport Mall

P.O. Box 10631

Jackson, Mississippi 39209

WATER WELL DRILLERS LOG

HANCOCK
C 2072
12-10-80

12-10 1980 Penton Well Serv Hancock
date well completed firm name county well located

LANDOWNER: <u>Oswald Fleming</u>	description of formations encountered	from	to
	<u>Surface Clay</u>	<u>0</u>	<u>20</u>
	<u>Sand</u>	<u>20</u>	<u>60</u>
<u>Picayune Ms</u> (mailing address)	<u>Blue Clay</u>	<u>60</u>	<u>200</u>
	<u>Silt</u>	<u>200</u>	<u>220</u>
WELL LOCATION: sec. <u>22</u> T. <u>6N</u> R. <u>16E</u> S W	<u>Blue Clay</u>	<u>220</u>	<u>560</u>
<u>5</u> miles <u>East</u> of <u>Picayune</u> (distance) (direction) (nearest town)	<u>Sand</u>	<u>560</u>	<u>673</u>
WELL PURPOSE: <u>Home</u> (home, irrigation, municipal, industrial)			
WELL COMPLETION DATA:			
(1) diameter (inches) <u>2"</u>			
(2) total depth (feet) <u>673'</u>			
(3) static water level (feet) <u>5'</u> below top of ground.			
(4) casing <u>Galv</u> , <u>663'</u> (material) (depth)			
<u>2"</u> (size) If telescope see back.			
(5) screen <u>10'</u> , <u>663'</u> (length) (depth to top)			
<u>2"</u> , <u>S. Steel</u> (size) (material)			
(6) pump <u>1/2</u> , <u>10</u> (HP) (yield gpm)			
<u>Elec</u> (type power)			
(7) electric log <u>No</u> (yes or no)			
(organization running log)			
(8) how well bottom plugged <u>Bw valve</u>			

DEPT. OF NATURAL RESOURCES
BUREAU OF LAND & WATER RESOURCES


DEC 15 1980

RECEIVED

DRILLERS REMARKS:

If well telescopes please sketch and show depths.

GROUND LEVEL

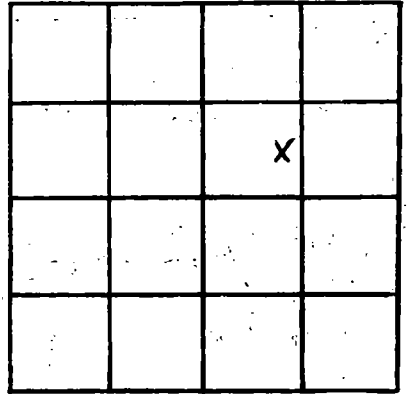

SECTION 22

Please indicate well location X.

ADDITIONAL INFORMATION

If more than one screen, show locations of each on sketch.