

MISSISSIPPI DEPARTMENT OF NATURAL RESOURCES

Bureau of Land and Water Resources

Southport Mall

P.O. Box 10631

Jackson, Mississippi 39209

WATER WELL DRILLERS LOG

Hancock
C 2043
4/19/81

4/19/1981 Pearcy with well seal Hancock
 date well completed firm name county well located

LANDOWNER: Janet Ferguson

Pearcy ms.
 (mailing address)

WELL LOCATION:
 sec. 7 T. 6 N R. 15 E
8 miles S E Pearcy
 (distance) (direction) (nearest town)

Description of formations encountered	from	to
Clay top soil	0	20
Sand Big gravel	20	40
top soil & junk	40	120
Clay	120	200
Sand with fine	200	230

WELL PURPOSE:
 (home, irrigation, municipal, industrial)

WELL COMPLETION DATA:

(1) diameter (inches) 2

(2) total depth (feet) 230

(3) static water level (feet) 32 below above top of ground.

(4) casing PVC, 220,
 (material) (depth)
2 if telescope see back.
 (size)

(5) screen 10, 220
 (length) (depth to top)
2, PVC
 (size) (material)

(6) pump 1 (HP) 10 (yield gpm)
2hp
 (type power)

(7) electric log (yes or no)
 (organization running log)


(8) how well bottom plugged BW

DEPT. OF NATURAL RESOURCES BUREAU OF LAND & WATER RESOURCES
MAY 19 1981
RECEIVED

DRILLERS REMARKS:

If well telescopes please sketch and show depths.

GROUND LEVEL

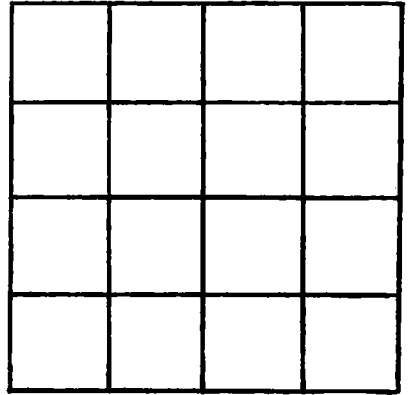

SECTION _____

Please indicate well location X.

ADDITIONAL INFORMATION

If more than one screen, show locations of each on sketch.