

**MISSISSIPPI DEPARTMENT OF NATURAL RESOURCES**  
**Bureau of Land and Water Resources**  
 Southport Mall  
 P.O. Box 10631  
 Jackson, Mississippi 39209  
**WATER WELL DRILLERS LOG**

**HANCOCK**  
 C 2046

1-20-82 date well completed      19 POUNCEY WATER WELL DRILLING firm name      Hancock county well located

**LANDOWNER:** PAT Palmisono  
White Cypress Lake  
Estates - Wood Home -  
 (mailing address)

description of formations encountered	from	to
Top	0	16
CSO - c' junk -	16	80
Blue Clay -	80	300
fine to good sd.	300	390

**WELL LOCATION:**  
 sec. 2 T 6 N. R. 15 E.  
15 miles E of Picayune  
 (distance) (direction) of (nearest town)

**WELL PURPOSE:** Home  
 (home, irrigation, municipal, industrial)

- WELL COMPLETION DATA:**
- (1) diameter (inches) 2
  - (2) total depth (feet) 390
  - (3) static water level (feet) 48 below top of ground
  - (4) casing PVC 380 (material) (depth)  
2 (size) If telescope see back.
  - (5) screen 10 (length) 380 (depth to top)  
2 (size) PVC (material)
  - (6) pump 1/2 (HP) 12 (yield gpm)  
AC 220 (type power)
  - (7) electric log \_\_\_\_\_ (yes or no)  
 \_\_\_\_\_ (organization running log)
  - (8) how well bottom plugged Sealed

**DRILLERS REMARKS:** good


DEPT. OF NATURAL RESOURCES  
 BUREAU OF LAND & WATER RESOURCES

FEB - 2 1982

**RECEIVED**

If well telescopes please sketch and show depths.

GROUND LEVEL

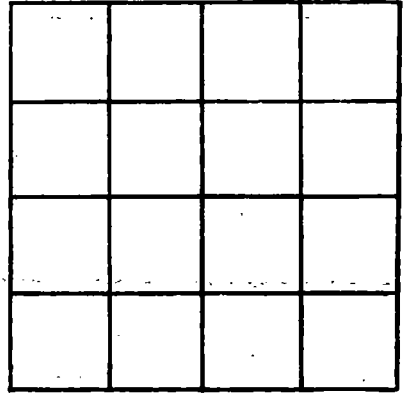

SECTION \_\_\_\_\_

Please indicate well location X.

ADDITIONAL INFORMATION

If more than one screen, show locations of each on sketch.