

MISSISSIPPI DEPARTMENT OF NATURAL RESOURCES

Bureau of Land and Water Resources

Southport Mall

P.O. Box 10631

Jackson, Mississippi 39209

WATER WELL DRILLERS LOG

Hancock
C2047

46 82
date well completed POUNCEY WATER WELL DRILLING firm name Hancock county well located

LANDOWNER: Mr. Louis Crispo - Rt 3 Praying
Ms. 39466
(mailing address)

description of formations encountered	from	to
<u>Top</u>	<u>0</u>	<u>18</u>
<u>sd gravel quarry</u>	<u>18</u>	<u>83</u>
<u>Light Blue Clay</u>	<u>83</u>	<u>118</u>
<u>sd. Fine Fine</u>	<u>236</u>	<u>263</u>
<u>Clay w/ ls</u>	<u>263</u>	<u>336</u>
<u>sd - some good</u>	<u>336</u>	<u>485</u>

WELL LOCATION:
sec. 5 T. 6 N. R. 15 E.
13 miles E of Praying
(distance) (direction) (nearest town)

WELL PURPOSE: Home Heat
(home, irrigation, municipal, industrial)

- WELL COMPLETION DATA:
- diameter (inches) 4
 - total depth (feet) 485
 - static water level (feet) 80 below top of ground
 - casing (material) PVC, (depth) 465
4 (size) If telescope see back.
 - screen (length) 20, (depth to top) 465
4 (size), PVC (material)
 - pump (HP) 1, (yield gpm) 30
230 AC (type power)
 - electric log (yes or no)
(organization running log) Sold.
 - how well bottom plugged Sold.

DEPT. OF NATURAL RESOURCES
BUREAU OF LAND & WATER RESOURCES


JUN - 1 1982

RECEIVED

DRILLERS REMARKS:

If well telescopes please sketch and show depths.

GROUND LEVEL

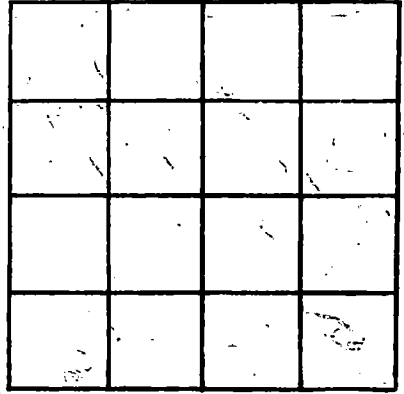

SECTION _____

Please indicate well location X.

ADDITIONAL INFORMATION

If more than one screen, show locations of each on sketch.