

MISSISSIPPI DEPARTMENT OF NATURAL RESOURCES

Bureau of Land and Water Resources

Southport Mall

P.O. Box 10631

Jackson, Mississippi 39209

WATER WELL DRILLERS LOG

POUNCEY WATER WELL DRILLING

Hancock
C 2048

4

48-82

Hancock

date well completed

firm name

county well located

LANDOWNER: Hayward Fleming Rt. 3 Pouncey

description of formations encountered

from

to

MS. 39466

(mailing address)

TOP	0	12
SD - gravel zone	12	72
Clay mix		
Clay Blue	72	222
SD & SD.	222	236
Clay HD Blue	236	308
SD only fine SD.	308	458
SD & gravel	458	472
Clay	472	482

WELL LOCATION:

sec 5 T 6 N R 15 E
13 miles E of Pouncey
(distance) (direction) (nearest town)

WELL PURPOSE: Home
(home, irrigation, municipal, industrial)

WELL COMPLETION DATA:

- (1) diameter (inches) 2
- (2) total depth (feet) 486
- (3) static water level (feet) 65 below above top of ground
- (4) casing PVC 476 (material) (depth)
2 (size) if telescope see back.
- (5) screen 10 476 (length) (depth to top)
2 PVC (size) (material)
- (6) pump 1 8 (HP) (yield gpm)
220V (type power)
- (7) electric log / (yes or no)
(organization running log)
- (8) how well bottom plugged Sealed

DRILLERS REMARKS:


DEPT. OF NATURAL RESOURCES
BUREAU OF LAND & WATER RESOURCES

JUN -1 1982

RECEIVED

If well telescopes please sketch and show depths.

GROUND LEVEL

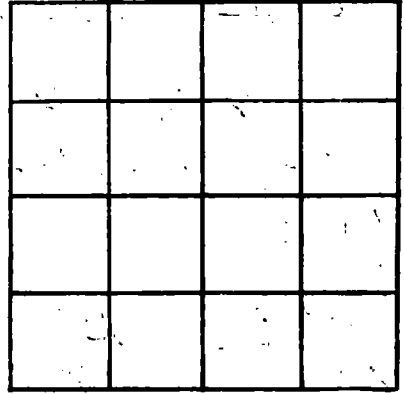

SECTION _____

Please indicate well location X.

ADDITIONAL INFORMATION

If more than one screen,
show locations of each on sketch.