

Hancock  
C 2153

MISSISSIPPI DEPARTMENT OF NATURAL RESOURCES  
Bureau of Land and Water Resources  
Southport Mall  
P.O. Box 10631  
Jackson, Mississippi 39209  
WATER WELL DRILLERS LOG

POUNCEY WATER WELL DRILLING Hancock  
date well completed 5-20 19 83 firm name county well located

LANDOWNER: Altin Lumpkin  
Pt 3 Picaune,  
Lee town town.  
(mailing address)

WELL LOCATION:  
sec. 5 T 6 N R 10 E  
S W  
10 miles E of Picaune  
(distance) (direction) (nearest town)

WELL PURPOSE: Home  
(home, irrigation, municipal, industrial)


- WELL COMPLETION DATA:
- (1) diameter (inches) 2
  - (2) total depth (feet) 208
  - (3) static water level (feet) 64 below above top of ground.
  - (4) casing PVC, 198  
(material) (depth)  
(size) if telescope see back.
  - (5) screen 10, 198  
(length) (depth to top)  
2 PVC  
(size) (material)
  - (6) pump 1, 8  
(HP) (yield gpm)  
AC 230  
(type power)
  - (7) electric log (yes or no)  
(organization running log)
  - (8) how well bottom plugged Sealed

description of formations encountered	depth	
	from	to
top	0	14
sd good shallow	14	60
sd clay mix	60	76
clay	76	188
sd	188	196
sd -	196	208

DRILLERS REMARKS:

If well telescopes please  
sketch and show depths.

**GROUND LEVEL**

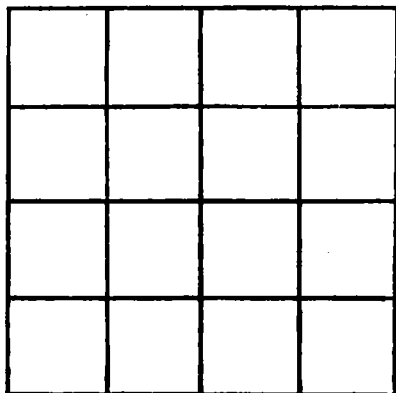

**SECTION** \_\_\_\_\_

**Please indicate well location X.**

**ADDITIONAL INFORMATION**

If more than one screen,  
show locations of each on sketch.