

MISSISSIPPI DEPARTMENT OF NATURAL RESOURCES
 Bureau of Land and Water Resources
 Southport Mall
 P.O. Box 10631
 Jackson, Mississippi 39209
WATER WELL DRILLERS LOG

HANCOCK
C. 2054
4-19-83

date well completed 4-19-83 **POUNCEY WATER WELL DRILLING** Form No. Hancock- county well located

LANDOWNER: Andy Hayes
RT 3 Piquem
 (mailing address)

description of formations encountered	from	to
<u>Top</u>	<u>0</u>	<u>18</u>
<u>sd - silt. gravel</u>	<u>18</u>	<u>131</u>
<u>clay mix</u>		
<u>Clay Blue</u>	<u>131</u>	<u>194</u>
<u>silt. to sand</u>	<u>196</u>	<u>232</u>
<u>Kelly</u>		

WELL LOCATION:
208 sec. 6 T. 6 N. R. 16 E.
10 miles E of Piquem
 (distance) (direction) (nearest town)

WELL PURPOSE: Home
 (home, irrigation, municipal, industrial)

WELL COMPLETION DATA:

(1) diameter (inches) 4 1/2

(2) total depth (feet) 232

(3) static water level (feet) 49 below above top of ground

(4) casing PVC, 217, 232
 (material), (depth), 15
217

(size) if telescope see back.

(5) screen 15, 217
 (length), (depth to top)

2, PVC
 (size), (material)

(6) pump 1/2, 14
 (HP), (yield gpm)

AC
 (type power)

(7) electric log yes or no
 (organization running log)

(8) how well bottom plugged Sand

DRILLERS REMARKS:



DEPT. OF NATURAL RESOURCES
 BUREAU OF LAND & WATER RESOURCES

MAY 18 1983

RECEIVED

If well telescopes please sketch and show depths.

GROUND LEVEL

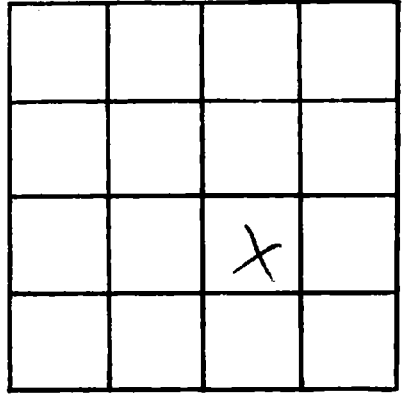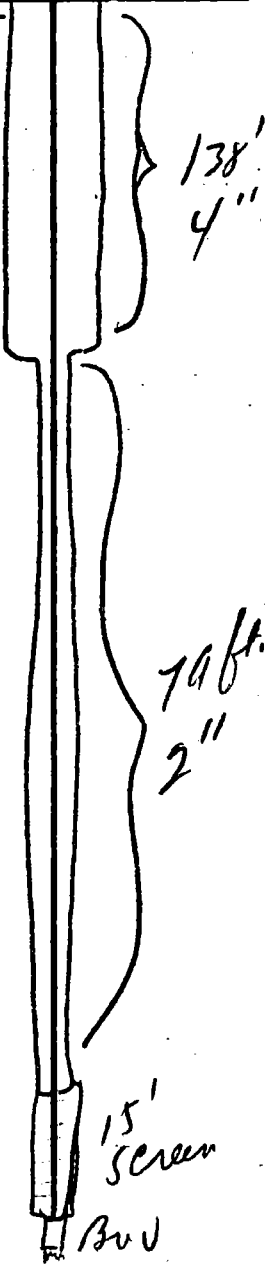

SECTION 8

Please indicate well location X.

ADDITIONAL INFORMATION

good well - later
flo. for 400 ft.
200 ft. for actual iron tube
good - set 4x2

If more than one screen,
show locations of each on sketch.