

MISSISSIPPI DEPARTMENT OF NATURAL RESOURCES

Bureau of Land and Water Resources

Southport Mall

P.O. Box 10631

Jackson, Mississippi 39209

WATER WELL DRILLERS LOG

HANCOCK  
C 9056  
4-22-83

*Hancock*

4-22-83 date well completed ~~POUNCEY WATER WELL DRILLING~~ county well located

LANDOWNER: *Harold Frank*  
*Rt. 3 Poyajune*  
(mailing address)

description of formations encountered from to

WELL LOCATION:  
sec. *6* T. *6* N. R. *15* E  
*10* miles *E* of *Poyajune*  
(distance) (direction) (nearest town)

*Top - 0 18*  
*sd. gravel 18 58*  
*Big to 58' used*  
*much well etc.*  
*Clay gravel 58 -61*  
*Clay sd - 61 171*

WELL PURPOSE: *stone*  
(home, irrigation, municipal, industrial)

*slt. 171 183*

WELL COMPLETION DATA:  
(1) diameter (inches) *2*  
(2) total depth (feet) *510*  
(3) static water level (feet) *32* below top of ground  
(4) casing *PVC 500* (material) (depth) *2* (size) if telescope see back.  
(5) screen *10 500* (length) (depth to top) *2 PVC* (size) (material)  
(6) pump *1 10* (HP) (yield gpm) *AC* (type power)  
(7) electric log (yes or no)  
(organization running log)  
(8) how well bottom plugged *Sealed*

*Clay 183 210*  
*slt. 210 240*  
*Clay 240 386*  
*slt. to fine sd - good 386 408*  
*but top fine*  
*Clay 408 457*  
*slt. 457 468*  
*sd. ding top 468 510*  
*fair good sd*  
*but fine.*

DEPT. OF NATURAL RESOURCES  
BUREAU OF LAND & WATER RESOURCES


MAY 18 1983

RECEIVED

DRILLERS REMARKS:

If well telescopes please sketch and show depths.

GROUND LEVEL

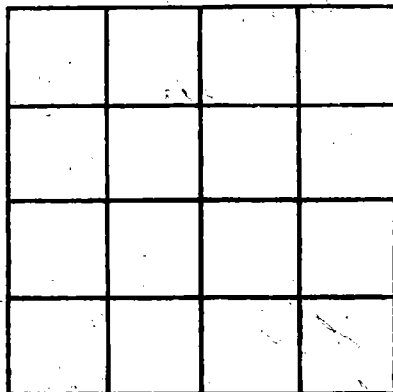

SECTION \_\_\_\_\_

Please indicate well location X.

ADDITIONAL INFORMATION

If more than one screen, show locations of each on sketch.