

MISSISSIPPI DEPARTMENT OF NATURAL RESOURCES

Bureau of Land and Water Resources

Southport Mall

P.O. Box 10631

Jackson, Mississippi 39209

WATER WELL DRILLERS LOG

POUNCEY WATER WELL DRILLING

Hancock

Hancock
C2060

1-31 19*84*
date well completed

firm name

county well located

LANDOWNER:

Mr. Herrick
Rt 3 Poyon
MS

(mailing address)

WELL LOCATION:

sec. *17* T. *6* N R. *15* E
8 miles *E* of *Poyon*
(distance) (direction) (nearest town)

WELL PURPOSE:

(home, irrigation, municipal, industrial)

WELL COMPLETION DATA:

- (1) diameter (inches) *4*
- (2) total depth (feet) *364*
- (3) static water level (feet) *41* below top of ground above
- (4) casing *PVC 3 1/4*
(material) (depth)
4 if telescope see back. (size)
- (5) screen *20 3 1/4*
(length) (depth to top)
4 (size) *PVC* (material)
- (6) pump *3 1/2 HP 35*
(HP) (yield gpm)
AC 226
(type power)
- (7) electric log (yes or no) */*
(organization running log)
- (8) how well bottom plugged */*

description of formations encountered

from

to

<i>top</i>	<i>0</i>	<i>12</i>
<i>sd</i>	<i>12</i>	<i>30</i>
<i>sd & gravel</i>	<i>30</i>	<i>50</i>
<i>gravel</i>		
<i>base clay</i>	<i>50</i>	<i>90</i>
<i>clay</i>	<i>90</i>	<i>208</i>
<i>sd to fin sd</i>	<i>208</i>	<i>230</i>
<i>clay</i>	<i>230</i>	<i>308</i>
<i>fin</i>	<i>308</i>	<i>330</i>
<i>fin to good</i>	<i>330</i>	<i>364</i>
<i>on bottom</i>		

DEPT. OF NATURAL RESOURCES
BUREAU OF LAND & WATER RESOURCES

APR 12 1984


DRILLERS REMARKS:

good well

RECEIVED

If well telescopes please sketch and show depths.

GROUND LEVEL

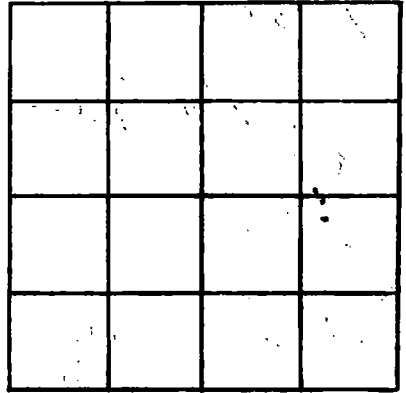

SECTION _____

Please indicate well location X.

ADDITIONAL INFORMATION

If more than one screen, show locations of each on sketch.