

MISSISSIPPI DEPARTMENT OF NATURAL RESOURCES
Bureau of Land and Water Resources
 Southport Mall
 P.O. Box 10631
 Jackson, Mississippi 39209
WATER WELL DRILLERS LOG

Hancock
C 2061

3-3-84 19 McNeil Wells Inc. Hancock
 date well completed firm name county well located

LANDOWNER: Ray Bennett

P.O. Box

Klein Miss

(mailing address)

description of formations encountered

from

to

mud 0 200
mud/sand 200 220
course sand 220 240

WELL LOCATION:

sec. 37 T. 7 N. R. 14 E
4 miles W of Klein
 (distance) (direction) (nearest town)

WELL PURPOSE: none
 (home, irrigation, municipal, industrial)

WELL COMPLETION DATA:

(1) diameter (inches) 2"
 (2) total depth (feet) 240'
 (3) static water level (feet) 10' below above top of ground.
 (4) casing PVC Sch. 40 230'
 (material) (depth)

— (size) if telescope see back.

(5) screen 10' 230'
 (length) (depth to top)
2" Sch. 80 PVC
 (size) (material)

(6) pump — (HP) — (yield gpm)

(type power)

(7) electric log yes
 (yes or no)

(organization running log)

(8) how well bottom plugged and seal

DRILLERS REMARKS:


DEPT. OF NATURAL RESOURCES
 BUREAU OF LAND & WATER RESOURCES

APR - 5 1984

RECEIVED

If well telescopes please sketch and show depths.

GROUND LEVEL

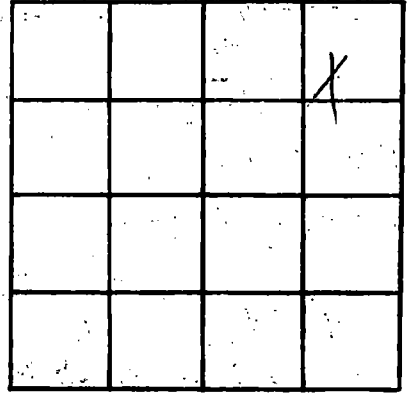

SECTION 37

Please indicate well location X.

ADDITIONAL INFORMATION

If more than one screen,
show locations of each on sketch.