

MISSISSIPPI DEPARTMENT OF NATURAL RESOURCES
 Bureau of Land and Water Resources
 Southport Mall
 P.O. Box 10631
 Jackson, Mississippi 39209
WATER WELL DRILLERS LOG

Hancock
C 200A

6-4- 1984 Wood Well Drg. Hancock
 date well completed firm name county well located

LANDOWNER: Jed Juwicek
Pt. 1, Bv 314X
Picayune, ms.
 (mailing address)

description of formations encountered	from	to
	<u>Clay</u>	<u>0</u>
<u>Sandy-clay</u>	<u>21</u>	<u>65</u>
<u>Blue clay - silty</u>	<u>65</u>	<u>190</u>
<u>SD</u>	<u>190</u>	<u>228</u>

WELL LOCATION:
 sec. 34 T. 6 N R. 16 E
15 miles NW of Kiln
 (distance) (direction) (nearest town)

WELL PURPOSE: Home
 (home, irrigation, municipal, industrial)

- WELL COMPLETION DATA:
- diameter (inches) 2"
 - total depth (feet) 228
 - static water level (feet) 48 ^(gauge) above top of ground.
 - casing PVC 218
 (material) (depth)
- If telescope see back.
 (size)
 - screen 10' -
 (length) (depth to top)
2" PVC
 (size) (material)
 - pump owner -
 (HP) (yield gpm)
-
 (type power)
 - electric log NO
 (yes or no)
N/A
 (organization running log)
 - how well bottom plugged OWU

DRILLERS REMARKS: N/A


DEPT. OF NATURAL RESOURCES
 BUREAU OF LAND & WATER RESOURCES

AUG 8 1984

RECEIVED

If well telescopes please sketch and show depths.

GROUND LEVEL

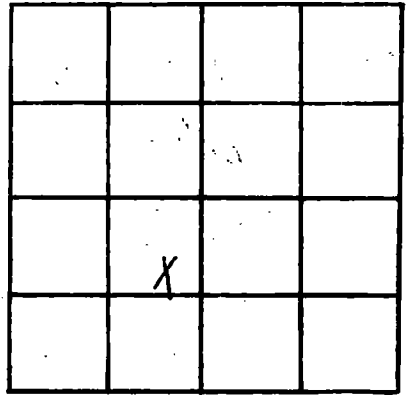

SECTION 34

Please indicate well location X.

ADDITIONAL INFORMATION

If more than one screen, show locations of each on sketch.