

MISSISSIPPI DEPARTMENT OF NATURAL RESOURCES

Bureau of Land and Water Resources

Southport Mall

P.O. Box 10631

Jackson, Mississippi 39209

WATER WELL DRILLERS LOG

Hancock
C 2066

Dec 23 1985 Walker Well Log Hancock
date well completed firm name county well located

LANDOWNER: Terry Lee
Picayune Miss
(mailing address)

description of formations encountered	from	to
<u>clay</u>	<u>0</u>	<u>18</u>
<u>sand</u>	<u>18</u>	<u>52</u>
<u>& gravel</u>		

WELL LOCATION:
sec 24 T 6 N R 16 E
5 miles E of Picayune
(distance) (direction) (nearest town)

WELL PURPOSE: HOME
(home, irrigation, municipal, industrial)

WELL COMPLETION DATA:

- (1) diameter (inches) 2"
- (2) total depth (feet) 52"
- (3) static water level (feet) 8 below above top of ground.
- (4) casing PVC 42'
(material) (depth)
 If telescope see back.
(size)
- (5) screen 10' 42'
(length) (depth to top)
10 PVC
(size) (material)
- (6) pump 1/2 6
(HP) (yield gpm)
1/2
(type power)
- (7) electric log
(yes or no)

(organization running log)
- (8) how well bottom plugged sand
shank


RECEIVED
FEB -7 1986

Department of Natural Resources
Bureau of Land & Water Resources

DRILLERS REMARKS:

If well telescopes please sketch and show depths.

GROUND LEVEL

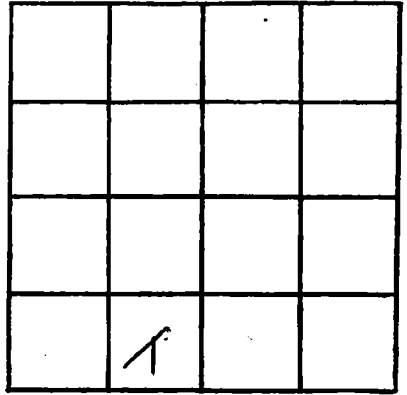

SECTION _____

Please indicate well location X.

ADDITIONAL INFORMATION

If more than one screen, show locations of each on sketch.