

MISSISSIPPI DEPARTMENT OF NATURAL RESOURCES

Bureau of Land and Water Resources

Southport Mall

P.O. Box 10631

Jackson, Mississippi 39209

WATER WELL DRILLERS LOG **HANCOCK**

HANCOCK
C2070

6-7 1986 PENTON WELL SERV. HANCOCK
date well completed firm name county well located

LANDOWNER: TERRY FORET
RT. 1 Box 371A PICAYUNE,
MS. 39466
(mailing address)

description of formations encountered	from	to
	<u>CLAY</u> <u>SAND</u>	<u>0</u> <u>20</u>

WELL LOCATION:
sec. 8 T. 6 S. R. 15 E.
8 miles EAST of PICAYUNE
(distance) (direction) (nearest town)

WELL PURPOSE: HOME
(home, irrigation, municipal, industrial)

- WELL COMPLETION DATA:
- (1) diameter (inches) 2"
 - (2) total depth (feet) 68'
 - (3) static water level (feet) 18' below above top of ground.
 - (4) casing PVC, 58',
(material) (depth)
2 if telescope see back.
(size)
 - (5) screen 10', 58',
" (length) (depth to top)
2, PVC
(size) (material)
 - (6) pump 1 (HP) (yield gpm)
Elec
(type power)
 - (7) electric log No
(yes or no)
(organization running log)
 - (8) how well bottom plugged BW.

RECEIVED


JUN 25 1986

Department of Natural Resources
Bureau of Land & Water Resources

DRILLERS REMARKS:

If well telescopes please sketch and show depths.

GROUND LEVEL

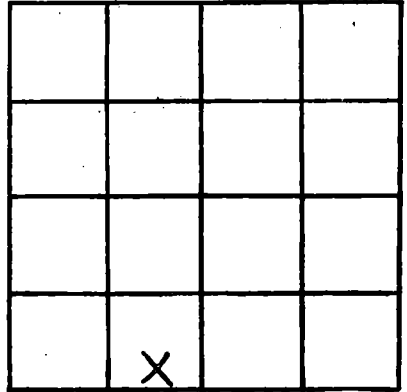

SECTION _____

Please indicate well location X.

ADDITIONAL INFORMATION

Lined area for additional information.

If more than one screen, show locations of each on sketch.