

MISSISSIPPI DEPARTMENT OF NATURAL RESOURCES

Bureau of Land and Water Resources

Southport Mall

P.O. Box 10631

Jackson, Mississippi 39209

WATER WELL DRILLERS LOG

POUNCEY WATER WELL DRILLING

*Hancock*

*Hancock*  
*C 2071*

*7-21* 19*86*  
date well completed

firm name

county well located

LANDOWNER: *Hancock*

*County -*

(mailing address)

WELL LOCATION:

sec. *5* T. *6* N. R. *15* E  
Velt *1* miles *SW* of *Lee's Chapel Church*  
(distance) (direction) (nearest town)

WELL PURPOSE: *Community Cent*  
(home, irrigation, municipal, industrial)

WELL COMPLETION DATA:

- (1) diameter (inches) 2
- (2) total depth (feet) 470
- (3) static water level (feet) 86 below above top of ground
- (4) casing PVC 460  
(material) (depth)  
2 if telescope see back.  
(size)
- (5) screen 10 460  
(length) (depth to top)  
2 PVC  
(size) (material)
- (6) pump 1 8  
(HP) (yield gpm)  
PC  
(type power)
- (7) electric log             
(yes or no)  
            
(organization running log)
- (8) how well bottom plugged Sealed

description of formations encountered

from to

<i>top</i>	0	18
<i>SD</i>	18	26
<i>Clay</i>	26	38
<i>SD gravel</i>	38	82
<i>Clay</i>	82	218
<i>SD</i>	218	251
<i>Clay</i>	251	418
<i>SD SD gravel</i>	418	470

RECEIVED


SEP 29 1986

Department of Natural Resources  
Bureau of Land & Water Resources

DRILLERS REMARKS:

If well telescopes please sketch and show depths.

GROUND LEVEL

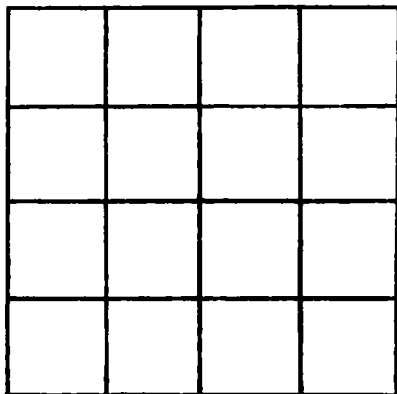

SECTION \_\_\_\_\_

Please indicate well location X.

ADDITIONAL INFORMATION

If more than one screen, show locations of each on sketch.