

MISSISSIPPI DEPARTMENT OF NATURAL RESOURCES

Bureau of Land and Water Resources

Southport Mall

P.O. Box 10631

Jackson, Mississippi 39209

WATER WELL DRILLERS LOG

POUNCEY WATER WELL DRILLING

HANCOCK
C 2075

8-8 1986
date well completed

firm name

Hancock
county well located

LANDOWNER: MIKE Crall

Rt 3 Lorton

(mailing address)

WELL LOCATION:

sec. 5 T 6 N R 15 E
3/4 miles S of Lorton
(distance) (direction) (nearest town)

WELL PURPOSE: Home
(home, irrigation, municipal, industrial)

WELL COMPLETION DATA:

- (1) diameter (inches) 4
- (2) total depth (feet) 436
- (3) static water level (feet) 75 below top of ground
- (4) casing PVC 416 (material) (depth)
4 (size) if telescope see back.
- (5) screen 2 416 (length) (depth to top)
2 PVC (size) (material)
- (6) pump 1 30 (HP) (yield gpm)
AC (type power)
- (7) electric log (yes or no)
- (organization running log)
- (8) how well bottom plugged Sealed

description of formations encountered

from to

TOP	0	12
sd	12	24
sd. junk	24	72
Clay	72	220
sd fine	220	232
Clay	232	272
sd good	272	389
good sd.	389	436

RECEIVED


SEP 29 1986

Department of Natural Resources
Bureau of Land & Water Resources

DRILLERS REMARKS:

If well telescopes please sketch and show depths.

GROUND LEVEL

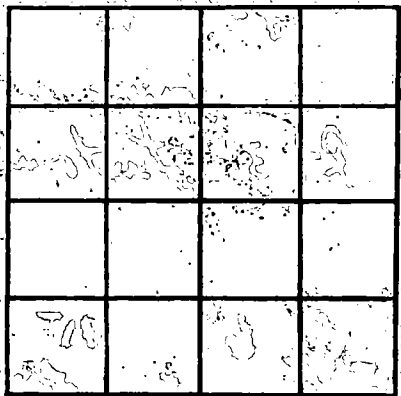

SECTION _____

Please indicate well location X.

ADDITIONAL INFORMATION

Multiple horizontal lines for providing additional information.

If more than one screen, show locations of each on sketch.