

# MISSISSIPPI DEPARTMENT OF NATURAL RESOURCES

Bureau of Land and Water Resources

P.O. Box 10631

Jackson, Mississippi 39209

WATER WELL DRILLERS LOG

COUNTY WELL LOCATED <b>HANCOCK</b>	
WELL NUMBER <b>C208B</b>	CODED
DATE WELL COMPLETED <b>10-22-88</b>	

PERMIT NUMBER <b>0-477</b>
NAME OF DRILLING FIRM <b>PENTON WELL SERV.</b>
<b>P.O. Box 91 Nicholson, MS.</b>

NAME & MAILING ADDRESS OF LANDOWNER <b>Scott Fleming</b>			
<b>15100 Fleming Rd #225</b>			
<b>PICAYUNE, MS. 39466</b>			
WELL LOCATION:	SEC	TOWNSHIP	RANGE
	<b>22</b>	<b>6 S</b>	<b>16 W</b>
DISTANCE	DIRECTION	NEAREST TOWN	
<b>4</b> Miles	<b>E.</b>	of <b>Picayune</b>	
OTHER LANDMARK			
WELL PURPOSE: <input checked="" type="radio"/> Home Irrigation, <input type="radio"/> Municipal, <input type="radio"/> Industrial, <input type="radio"/> Fish Pond, etc.			

<b>PUMP DATA</b>		
PUMP TYPE (Circle One): Submersible, Turbine, <input checked="" type="radio"/> Jet, Flowing Well, Other (Describe) _____		
POWER TYPE (Circle One): <input checked="" type="radio"/> Electric, Tractor, Diesel, Gasoline, Butane, Other (Describe) _____		
Pump Capacity (GPM)	No. of Stages	Setting Depth  <b>FT.</b>
PUMP TEST		
Well yielded _____ GPM with a drawdown of _____ ft. after _____ hours of pumping		

<b>WELL DATA</b>		
Well Depth <b>630</b>	Casing Diameter (In.) <b>2"</b>	Casing Length (Ft.) <b>620</b>
Type of Casing <b>PVC</b>	Hole Depth <b>630</b>	Depth to Static Water Level <b>18</b>
TYPE OF COMPLETION: (Circle One or More): <input checked="" type="radio"/> Gravel Packed, <input type="radio"/> Underreamed, <input type="radio"/> Telescoped, <input checked="" type="radio"/> Natural Development, <input type="radio"/> Open Hole, <input type="radio"/> Other (Describe) _____		
Top of Lap Pipe or Reduction in Casing  <b>FEET</b> IF TELESCOPED OR MORE THAN ONE SCREEN: USE BACK PAGE		

<b>LOG DATA</b>	
TYPE OF LOG RUN (Circle One): Electric, Gamma Ray, Density, Sonic, Neutron, Other (Describe) _____	
<input checked="" type="radio"/> No Log Run	
Name of Organization Running Log	

<b>SCREEN DATA</b>		
Diameter - Inches <b>2</b>	Length - Feet <b>10</b>	Slot Size - Inches <b>10</b>
Screen Type <b>PVC</b>	Depth to Bottom - Feet <b>620-630</b>	


<b>GEOLOGIC DATA (Office Use Only)</b>			
Surface Elev.	Geologic Unit	Unit Thickness	Depth to Top
Subs. SWL	Date	Analysis	Aquifer Test
Driller's Remarks			

DESCRIPTION OF FORMATIONS ENCOUNTERED	FROM	TO	FORMATIONS (Continued)	FROM	TO
<b>CLAY</b>	<b>0</b>	<b>15</b>	<b>RECEIVED</b>  <b>NOV 16 1988</b>  Department of Natural Resources Bureau of Land & Water Resources		
<b>SAND</b>	<b>15</b>	<b>60</b>			
<b>Blue CLAY</b>	<b>60</b>	<b>255</b>			
<b>SAND</b>	<b>255</b>	<b>300</b>			
<b>Blue CLAY</b>	<b>300</b>	<b>575</b>			
<b>SAND</b>	<b>575</b>	<b>630</b>			

IF MORE SPACE IS NEEDED, USE BACK

If well telescopes please sketch and show depths.

GROUND LEVEL

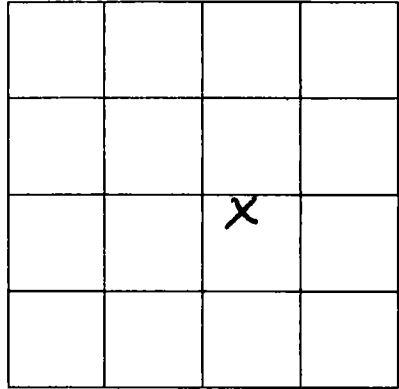

SECTION 22

Please indicate well location X.

ADDITIONAL INFORMATION

If more than one screen, show location of each on sketch.