

**MISSISSIPPI DEPARTMENT OF NATURAL RESOURCES**  
Bureau of Land and Water Resources

P.O. Box 10631

Jackson, Mississippi 39209

**WATER WELL DRILLERS LOG**

COUNTY WELL LOCATED  
**HANCOCK**

WELL NUMBER CODED  
**C2085**

DATE WELL COMPLETED  
**2-28-89**

PERMIT NUMBER  
**0-477**

NAME OF DRILLING FIRM  
**PENTON WELL SERV.**

**P.O. Box 91 Nicholson, MS.**

NAME & MAILING ADDRESS OF LANDOWNER **JOB FOR**  
**Don Ginn (Ginn Realty)**

**Hwy 43 S.**

**Piedmont, MS. 39466**

WELL LOCATION: SEC TOWNSHIP RANGE  
**4 6 S 15 W**

DISTANCE DIRECTION NEAREST TOWN  
**1 Miles S.E. of Leetown**

OTHER LANDMARK **Lee's Chapel #7**  
**1m. S.E. Leetown Church**

WELL PURPOSE: Home, Irrigation, Municipal, Industrial, Fish Pond, etc.  
**HOME**

**PUMP DATA**

PUMP TYPE (Circle One):  
Submersible, Turbine, **Jet** Flowing Well,  
Other (Describe) \_\_\_\_\_

POWER TYPE (Circle One):  
**Electric**, Tractor, Diesel, Gasoline, Butane,  
Other (Describe) \_\_\_\_\_

Pump Capacity (GPM)	No. of Stages	Setting Depth
		FT.

PUMP TEST

Well yielded \_\_\_\_\_ GPM with  
a drawdown of \_\_\_\_\_ ft.  
after \_\_\_\_\_ hours of pumping

**WELL DATA**

Well Depth <b>440'</b>	Casing Diameter (In.) <b>2"</b>	Casing Length (Ft.) <b>430'</b>
Type of Casing <b>PVC</b>	Hole Depth <b>440'</b>	Depth to Static Water Level <b>85'</b>

TYPE OF COMPLETION: (Circle One or More):  
**Natural Development**, Underreamed, Telescoped,  
Open Hole, Other

Top of Lap Pipe or Reduction in Casing

FEET IF TELESCOPED OR MORE THAN ONE SCREEN: USE BACK PAGE

**LOG DATA**

TYPE OF LOG RUN (Circle One): **No Log Run**,  
Electric, Gamma Ray, Density, Sonic, Neutron,  
Other (Describe) \_\_\_\_\_

Name of Organization Running Log

**SCREEN DATA**

Diameter - Inches <b>2"</b>	Length - Feet <b>10'</b>	Slot Size - Inches <b>10</b>
Screen Type <b>PVC</b>	Depth to Bottom - Feet <b>430-440</b>	

**GEOLOGIC DATA (Office Use Only)**


Surface Elev.	Geologic Unit	Unit Thickness	Depth to Top
Subs. SWL	Date	Analysis	Aquifer Test

Driller's Remarks  
**\* Well AT END of Tom Lee Rd.**

DESCRIPTION OF FORMATIONS ENCOUNTERED	FROM	TO	FORMATIONS (Continued)	FROM	TO
<b>CLAY</b>	<b>0</b>	<b>15</b>	<b>DISCONTINUED</b>		
<b>Red SAND</b>	<b>15</b>	<b>95</b>			
<b>BLUE CLAY</b>	<b>95</b>	<b>255</b>			
<b>SAND</b>	<b>255</b>	<b>285</b>			
<b>BLUE CLAY</b>	<b>285</b>	<b>380</b>			
<b>SAND</b>	<b>380</b>	<b>440</b>			
			<b>Department of Natural Resources</b>		
			<b>Bureau of Land &amp; Water Resources</b>		
			IF MORE SPACE IS NEEDED, USE BACK		

If well telescopes please sketch and show depths.

GROUND LEVEL

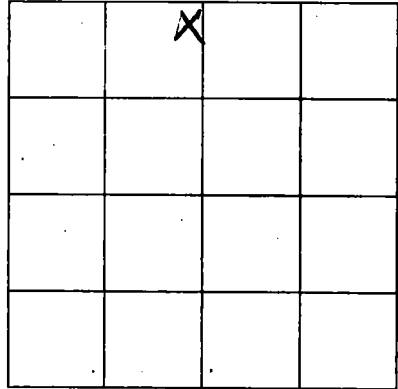

SECTION 4

Please indicate well location X.

ADDITIONAL INFORMATION

If more than one screen,  
show location of each on sketch.