

MISSISSIPPI DEPARTMENT OF NATURAL RESOURCES

Bureau of Land and Water Resources

P.O. Box 10631

Jackson, Mississippi 39209

WATER WELL DRILLERS LOG

COUNTY WELL LOCATED <i>Hancock</i>	
WELL NUMBER <i>C2091</i>	CODED
DATE WELL COMPLETED <i>6-2-89</i>	

PERMIT NUMBER <i>0-493</i>
NAME OF DRILLING FIRM <i>Dolley Beech's</i>
<i>Well Works</i>

NAME & MAILING ADDRESS OF LANDOWNER <i>Donna Walker</i>			
WELL LOCATION			
SEC	TOWNSHIP	RANGE	
	<i>6 N</i>	<i>16 E</i>	
DISTANCE		DIRECTION	NEAREST TOWN
Miles of			
OTHER LANDMARK			
WELL PURPOSE <u>Home</u> Irrigation, Municipal, Industrial, Fish Pond, etc.			

PUMP DATA		
PUMP TYPE (Circle One): Submersible, Turbine, <u>Lat</u> Flowing Well, Other (Describe)		
POWER TYPE (Circle One): <u>Electric</u> , Tractor, Diesel, Gasoline, Butane, Other (Describe) H/P		
Pump Capacity (GPM)	No. of Stages	Setting Depth
	<i>2</i>	
FT.		
PUMP TEST		
Well yielded _____ GPM with a drawdown of _____ ft. after _____ hours of pumping		

WELL DATA		
Well Depth <i>651</i>	Casing Diameter (In.) <i>5"</i>	Casing Length (Ft.) <i>20</i>
Type of Casing <i>POC</i>	Hole Depth <i>651</i>	Depth to Static Water Level <i>41</i>
TYPE OF COMPLETION: (Circle One or More): <u>Natural Development</u> , Gravel Packed, Underreamed, Telescoped, Open Hole, Other		
Top of Lap Pipe or Reduction in Casing		
FEET IF TELESCOPED OR MORE THAN ONE SCREEN: USE BACK PAGE		

LOG DATA			
TYPE OF LOG RUN (Circle One): <u>No Log Run</u> , Electric, Gamma Ray, Density, Sonic, Neutron, Other (Describe)			
Name of Organization Running Log <i>Dolley Beech</i>			
GEOLOGIC DATA (Office Use Only)			
Surface Elev.	Geologic Unit	Unit Thickness	Depth to Top
Subs. SWL	Date	Analysis	Aquifer Test

SCREEN DATA		
Diameter - Inches <i>5"</i>	Length - Feet <i>20</i>	Slot Size - Inches <i>#8</i>
Screen Type <i>Johnson Screens</i>		Depth to Bottom - Feet <i>651</i>

Driller's Remarks <i>Fine Well</i>

DESCRIPTION OF FORMATIONS ENCOUNTERED	FROM	TO	FORMATIONS ENCOUNTERED	FROM	TO
			RECEIVED		
			JUN 6 1989		
			Department of Natural Resources Bureau of Land & Water Resources		

IF MORE SPACE IS NEEDED, USE BACK


If well telescopes please sketch and show depths.

GROUND LEVEL

SECTION _____

Please indicate well location X.

ADDITIONAL INFORMATION

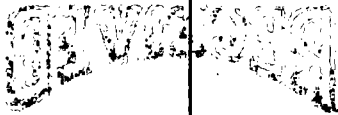

Faint illegible text below the stamp.

Faint illegible text at the bottom of the page.

If more than one screen, show location of each on sketch.