

MISSISSIPPI DEPARTMENT OF NATURAL RESOURCES

Bureau of Land and Water Resources

P.O. Box 10631
Jackson, Mississippi 39209
WATER WELL DRILLERS LOG

COUNTY WELL LOCATED <i>Hancock</i>	
WELL NUMBER <i>C-3003</i>	CODED <i>2103</i>
DATE WELL COMPLETED <i>4-21-92</i>	

PERMIT NUMBER
NAME OF DRILLING FIRM <i>Douney</i>

NAME & MAILING ADDRESS OF LANDOWNER <i>Jimmy Bounds - Hy 43 RD 3 Prayin</i>			
WELL LOCATION: SEC	TOWNSHIP	RANGE	
<i>19</i>	<i>E</i>	<i>N 15</i>	<i>E</i>
DISTANCE <i>1/2</i> Miles	DIRECTION <i>E</i>	NEAREST TOWN <i>Paleo</i>	
OTHER LANDMARK <i>1st. Home East Mitchell Rd.</i>			
WELL PURPOSE: Home, Irrigation, Municipal, Industrial, Fish Pond, etc.			

PUMP DATA		
PUMP TYPE (Circle One): Submersible, Turbine, Jet , Flowing Well, Other (Describe) _____		
POWER TYPE (Circle One): Electric , Tractor, Diesel, Gasoline, Butane, Other (Describe) _____ H/P _____		
Pump Capacity (GPM) <i>9A</i>	No. of Stages <i>2</i>	Setting Depth <i>10</i> FT.
PUMP TEST Well yielded <i>16</i> GPM with a drawdown of _____ ft. after _____ hours of pumping		


WELL DATA		
Well Depth <i>230</i>	Casing Diameter (In.) <i>2</i>	Casing Length (Ft.) <i>220</i>
Type of Casing <i>PH</i>	Hole Depth <i>230</i>	Depth to Static Water Level <i>22</i>
TYPE OF COMPLETION: (Circle One or More): Gravel Packed, Underreamed, Telescoped, Natural Development , Open Hole, Other (Describe) _____		
Top of Lap Pipe or Reduction in Casing FEET IF TELESCOPED OR MORE THAN ONE SCREEN: USE BACK PAGE		

LOG DATA	
TYPE OF LOG RUN (Circle One): No Log Run, Electric, Gamma Ray, Density, Sonic, Neutron, Other (Describe) _____	
Name of Organization Running Log	

SCREEN DATA		
Diameter - Inches <i>2</i>	Length - Feet <i>10</i>	Slot Size - Inches <i>5/64</i> <i>5/32</i>
Screen Type <i>pre wrap</i>		Depth to Bottom - Feet <i>230</i>

GEOLOGIC DATA (Office Use Only)			
Surface Elev.	Geologic Unit	Unit Thickness	Depth to Top
Subs. SWL	Date	Analysis	Aquifer Test
Driller's Remarks			

DESCRIPTION OF FORMATIONS ENCOUNTERED	FROM	TO
<i>Top</i>	<i>0</i>	<i>12</i>
<i>SD & gravel</i>	<i>12</i>	<i>125</i>
<i>Bed " 102-125</i>		
<i>clay</i>	<i>125</i>	<i>192</i>
<i>SD to 12' good SD.</i>	<i>192</i>	<i>230</i>

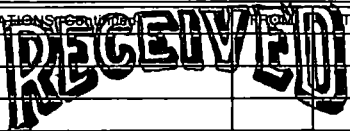

MAY 29 1992

Dept. of Environmental Quality
Bureau of Land & Water Resources

IF MORE SPACE IS NEEDED, USE BACK

RECEIVED

Printed and Published for the
Proprietor by the