

**MISSISSIPPI DEPARTMENT OF ENVIRONMENTAL QUALITY**  
Bureau of Land and Water Resources

P. O. Box 10631  
Jackson, MS 39289-0631  
**WATER WELL DRILLERS LOG**

COUNTY WELL LOCATED <i>Hancock</i>	
WELL NUMBER <i>C2110</i>	CODED
DATE WELL COMPLETED <i>3-23-95</i>	

PERMIT NUMBER
NAME OF DRILLING FIRM <i>Poanony</i>

NAME & MAILING ADDRESS OF LANDOWNER <i>C. J. Fosi</i> <i>Bobby Cufasi</i> <i>Tom Lee Rd.</i> <i>P.O. Box 115</i>		
WELL LOCATION: SEC	TOWNSHIP	RANGE
<i>4</i>	<i>60<sup>N</sup></i>	<i>15<sup>E</sup></i>
DISTANCE <i>1 1/4</i> Miles	DIRECTION <i>South</i>	NEAREST TOWN <i>Lepton</i>
OTHER LANDMARK <i>old Culbert Lee Place</i>		
WELL PURPOSE: Home, Irrigation, Municipal, Industrial, Fish Pond, etc.		

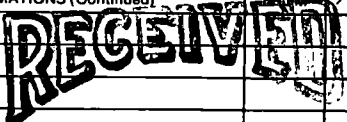
<b>PUMP DATA</b>		
PUMP TYPE (Circle One): Submersible, Turbine, <u>Jet</u> Flowing Well, Other (Describe) _____		
POWER TYPE (Circle One): <u>Electric</u> Tractor, Diesel, Gasoline, Butane, Other (Describe) _____ H/P _____		
Pump Capacity (GPM) <i>12</i>	No. of Stages <i>2</i>	Setting Depth <i>70</i> FT.
PUMP TEST		
Well yielded <i>12</i> GPM with a drawdown of _____ ft. after _____ hours of pumping		

<b>WELL DATA</b>		
Well Depth <i>96</i>	Casing Diameter (In.) <i>2</i>	Casing Length (Ft.) <i>76</i>
Type of Casing <i>PC</i>	Hole Depth <i>96</i>	Depth to Static Water Level <i>46'</i>
TYPE OF COMPLETION: (Circle One or More): <u>Gravel Packed</u> , Underreamed, Telescoped, Natural Development, Open Hole, Other (Describe) _____		
Top of Lap Pipe or Reduction in Casing  FEET IF TELESCOPED OR MORE THAN ONE SCREEN: USE BACK PAGE		

<b>LOG DATA</b>	
TYPE OF LOG RUN (Circle One): No Log Run, Electric, Gamma Ray, Density, Sonic, Neutron, Other (Describe) _____	
Name of Organization Running Log	

<b>SCREEN DATA</b>		
Diameter - Inches <i>2</i>	Length - Feet <i>70</i>	Slot Size - Inches <i>008</i>
Screen Type <i>Pre-wrap</i>	Depth to Bottom - Feet <i>96</i>	

<b>GEOLOGIC DATA (Office Use Only)</b>			
Surface Elev.	Geologic Unit	Unit Thickness	Depth to Top
Subs. SWL	Date	Analysis	Aquifer Test
Driller's Remarks			

DESCRIPTION OF FORMATIONS ENCOUNTERED	FROM	TO	FORMATIONS (Continued)	FROM	TO
<i>TOP 5' fine shales</i>	<i>0</i>	<i>12</i>	 <b>JUL 06 1995</b>  Dept. of Environmental Quality Office of Land & Water Resources		
<i>harder</i>		<i>95</i>			

IF MORE SPACE IS NEEDED, USE BACK

If well telescopes please  
sketch and show depths.

GROUND LEVEL


SECTION \_\_\_\_\_

Please indicate well location X.

ADDITIONAL INFORMATION

If more than one screen,  
show location of each on sketch.