

POUNCEY WATER WELLS

Adron A. Pouncey
 10200 Possum Fork
 Piquette, MS 39466

P. O. Box 10631
 Jackson, MS 39289-0631
WATER WELL DRILLERS LOG

COUNTY WELL LOCATED
Leflore

WELL NUMBER
C 2117

CODED

PERMIT NUMBER

DATE WELL COMPLETED
12/11/96

NAME OF DRILLER
Pouncey

NAME & MAILING ADDRESS OF LANDOWNER
Kan Duit Coast

WELL LOCATION: SEC *17* TOWNSHIP *6^S* RANGE *15^E*

DISTANCE *4* Miles *S* of *Lepton*

OTHER LANDMARK
1st. Big-Metal Rd. 1/2 mi. S of

WELL PURPOSE: Home, Irrigation, Municipal, Industrial, Fish Pond, etc.
off 43-

PUMP DATA

PUMP TYPE (Circle One):
 Submersible, Turbine, Jet Flowing Well,
 Other (Describe) _____

POWER TYPE (Circle One):
 Electric, Tractor, Diesel, Gasoline, Butane,
 Other (Describe) _____ H/P _____

Pump Capacity (GPM) *12A* No. of Stages *2* Setting Depth *80* FT.

PUMP TEST

Well yielded *10* GPM with
 a drawdown of _____ ft.
 after _____ hours of pumping

WELL DATA

Well Depth *410'* Casing Diameter (In.) *2* Casing Length (Ft.) *395*

Type of Casing *PVC* Hole Depth *410'* Depth to Static Water Level *42'*

TYPE OF COMPLETION: (Circle One or More):
 Gravel Packed, Underreamed, Telescoped,
 Natural Development, Open Hole, Other
 (Describe) _____

Top of Lap Pipe or Reduction in Casing

FEET IF TELESCOPED OR MORE THAN ONE SCREEN: USE BACK PAGE

LOG DATA

TYPE OF LOG RUN (Circle One):
 No Log Run, Electric, Gamma Ray, Density, Sonic, Neutron,
 Other (Describe) _____

Name of Organization Running Log

SCREEN DATA

Diameter - Inches *2* Length - Feet *15* Slot Size - Inches *10-10*
5-12

Screen Type *PVC wrap* Depth to Bottom - Feet *410'*


GEOLOGIC DATA (Office Use Only)

Surface Elev.	Geologic Unit	Unit Thickness	Depth to Top

Driller's Remarks
5' 10' Bolter
40' Casing
10' 10-12 at 350'

DESCRIPTION OF FORMATIONS ENCOUNTERED	FROM	TO	SPERMATION COMPANY	DATE	FROM	TO
<i>Sl. op.</i>	<i>0</i>	<i>18</i>	<i>Leflore</i>	<i>1996</i>	<i>0</i>	<i>410</i>
<i>Blue sly.</i>	<i>146</i>	<i>182</i>				
<i>Blue</i>	<i>288</i>					
<i>Sl. to cont 10' good</i>	<i>350</i>					
<i>soft shale sly.</i>	<i>390</i>					

IF MORE SPACE IS NEEDED, USE BACK

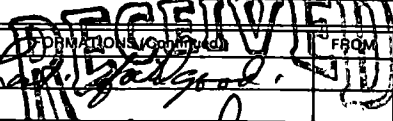

If well telescopes please sketch and show depths.

GROUND LEVEL

SECTION _____

Please indicate well location X.

ADDITIONAL INFORMATION

If more than one screen, show location of each on sketch.