

Hancock
D 3
3-5-70

MISSISSIPPI
BOARD OF WATER COMMISSIONERS
416 North State Street
Jackson, Mississippi 39201

COPIED

WATER WELL DRILLERS LOG

3-5 1970 Panten Well Serv Hancock
date well completed firm name county well located

LANDOWNER: Huey Woodcock
Pt. 1 Box 614 B
Caulport Miss
(mailing address)

description of formations encountered

from to

Surface clay	0	12
White clay	12	35
Blue clay	35	67
Mud	67	75
Sand	75	78
White clay	78	132
Blue clay	132	312
Grey sand	312	356

WELL LOCATION:

sec 24 T 6 R 14
1/2 miles West of Vidalia
(distance) (direction) (nearest town)

WELL PURPOSE: Home
(home, irrigation, municipal, industrial)

WELL COMPLETION DATA: 4"m

- (1) diameter (inches) 2"
- (2) total depth (feet) 356
- (3) static water level (feet) 54 below top of ground
- (4) casing Galv 351
(material) (depth)
2" (size) If telescope see back.
- (5) screen 5' 351
(length) (depth to top)
- (6) pump 1 11
(HP) (yield gpm)
Elec
(type power)
- (7) electric log No
(yes or no)

(organization running log)

(8) how well bottom plugged BW Valve

DRILLERS REMARKS:


COPIED

MAR 12 1970

MISS. BD. OF
WATER COMM.

If well telescopes please sketch and show depths.

GROUND LEVEL

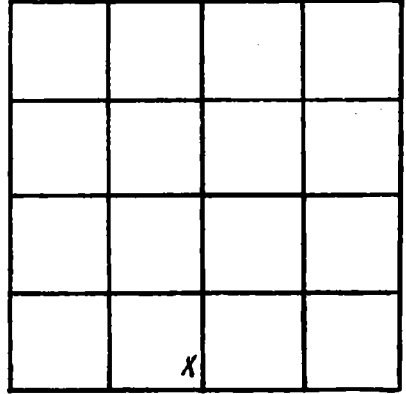

SECTION 24

Please indicate well location X.

ADDITIONAL INFORMATION

If more than one screen, show locations of each on sketch.