

Hancock
D 7
4-24-70

MISSISSIPPI
BOARD OF WATER COMMISSIONERS
416 North State Street
Jackson, Mississippi 39201

CODED

WATER WELL DRILLERS LOG

4-24 1970 Penton Well Serv Hancock
date well completed firm name county well located

LANDOWNER: Perline Lzdner
Rt. 1 Box 210 A
Pass Christian Miss
(mailing address)

description of formations encountered	from	to
Surface Clay	0	18
Red sand	18	22
White Clay	22	35
Blue Clay	35	125
Fine sand	125	150
Blue Clay	150	278
Grey sand	278	295

WELL LOCATION:
sec. 10 T 6 R 14
0 miles South of Standard
(distance) (direction) (nearest town)

WELL PURPOSE: Home
(home, irrigation, municipal, industrial)

WELL COMPLETION DATA:

(1) diameter (inches) 2

(2) total depth (feet) 299

(3) static water level (feet) 91 below top of ground.

(4) casing Galv, 294,
(material) (depth)
2 If telescope see back.
(size)

(5) screen 5', 294
(length) (depth to top)
2, S. Steel
(size) (material)

(6) pump 1 6
(HP) (yield gpm)
Elec
(type power)

(7) electric log NO
(yes or no)


(organization running log)

(8) how well bottom plugged Ball Valve

DRILLERS REMARKS: MAY 5 1970

If well telescopes please sketch and show depths.

GROUND LEVEL

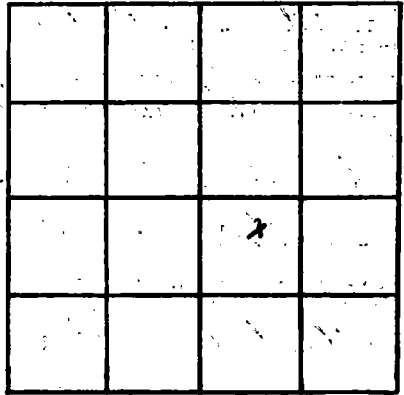

SECTION 10

Please indicate well location X.

ADDITIONAL INFORMATION

If more than one screen, show locations of each on sketch.