

HANCOCK
D17
2-20-71

MISSISSIPPI
BOARD OF WATER COMMISSIONERS
416 North State Street
Jackson, Mississippi 39201
WATER WELL DRILLERS LOG

CODED

Feb. 20 1971 S&S well works Noncock
date well completed firm name county well located

LANDOWNER: Wayne Crenshaw
Pt 1 Oschristian
Miss.
(mailing address)

description of formations encountered	from	to
top soil	0	2
clay	2	40
sand	40	63

WELL LOCATION:
sec. 7 T. 6 N R. 14 E
4 miles W of Standard
(distance) (direction) (nearest town)

WELL PURPOSE: Home
(home, irrigation, municipal, industrial)

- WELL COMPLETION DATA:
- (1) diameter (inches) 2 in.
 - (2) total depth (feet) 63 ft.
 - (3) static water level (feet) 40 below top of ground.
 - (4) casing P.V.C., 53' (material) (depth)
2" (size) if telescope see back.
 - (5) screen 10' 53' (length) (depth to top)
2" P.V.C. (size) (material)
 - (6) pump 1 3 (HP) (yield gpm)
6 (type power)
 - (7) electric log No (yes or no)

CODED

(organization running log) B.W.
(8) how well bottom plugged


MAR 16 1971

DRILLERS REMARKS:
None

MISS. BD. OF
WATER COMM.

If well telescopes please sketch and show depths.

GROUND LEVEL

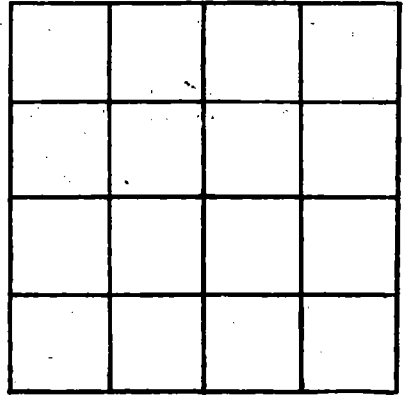

SECTION _____

Please indicate well location X.

ADDITIONAL INFORMATION

If more than one screen,
show locations of each on sketch.