

HANCOCK

D 18

3-1-71

MISSISSIPPI BOARD OF WATER COMMISSIONERS  
416 North State Street  
Jackson, Mississippi 39201

**CODED**

WATER WELL DRILLERS LOG

March 1 1971  
date well completed

SLS Well Works  
firm name

Hancock  
county well located

LANDOWNER: L. D. Head

Rt. 1 Pochristian

Miss.

(mailing address)

description of formations encountered

from

to

top soil  
clay  
sand

0 3  
3 280  
280 300

WELL LOCATION:

sec. 2 T 6 N R 14 E  
0 miles W of Standard  
(distance) (direction) (nearest town)

WELL PURPOSE: HOME  
(home, irrigation, municipal, industrial)

WELL COMPLETION DATA:

- (1) diameter (inches) 2 in.
- (2) total depth (feet) 300
- (3) static water level (feet) 100 below top of ground.
- (4) casing M 290 (material) (depth)  
2 in (size) if telescope see back.
- (5) screen 10 290 (length) (depth to top)  
2 in (size) SS (material)
- (6) pump 1 5 (HP) (yield gpm)  
E (type power)
- (7) electric log no (yes or no)

**CODED**

(organization running log)

(8) how well bottom plugged B.W.

MAR 16 1971


MISS. BD. OF WATER COMM.

DRILLERS REMARKS:

None

If well telescopes please sketch and show depths.

GROUND LEVEL

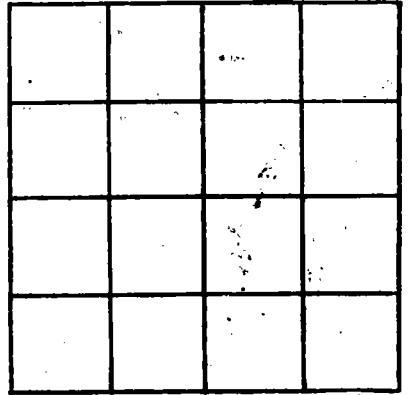

SECTION \_\_\_\_\_

Please indicate well location X.

ADDITIONAL INFORMATION

If more than one screen,  
show locations of each on sketch.