

HANCOCK

D19

3-8-71

MISSISSIPPI
 BOARD OF WATER COMMISSIONERS
 416 North State Street
 Jackson, Mississippi 39201

CODED

WATER WELL DRILLERS LOG

Nov 8 1971
date well completed

S.T.S.
firm name

Hancock
county well located

LANDOWNER: Roger Perkins

description of formations encountered

from

to

P.O. 1
Pass Christian
(mailing address)

Top soil
Clay
sand
gravel

0 2
2 15
15 40
40 50

WELL LOCATION:

sec. 2 T. 6 N R. 14 E
0 miles (distance) of Standard (direction) of Standard (nearest town)

WELL PURPOSE: Home
(home, irrigation, municipal, industrial)

WELL COMPLETION DATA:

- (1) diameter (inches) 2
- (2) total depth (feet) 50
- (3) static water level (feet) 50 below above top of ground.
- (4) casing P.V.C. 40 (material) (depth)
2 (size) if telescope see back.
- (5) screen 10 40 (length) (depth to top)
2 P.V.C. (size) (material)
- (6) pump 1 6 (HP) (yield gpm)
E (type power)
- (7) electric log No (yes or no)
(organization running log)
- (8) how well bottom plugged B.W.

CODED

Please send me some self addressed envelopes & some log books.

MAR 16 1971


MISS. BD. OF
WATER COM.

DRILLERS REMARKS:

Done

If well telescopes please sketch and show depths.

GROUND LEVEL

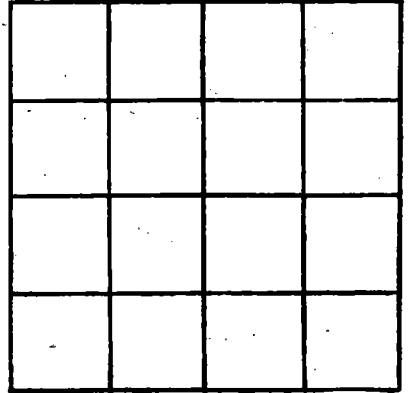

SECTION _____

Please indicate well location X.

ADDITIONAL INFORMATION

If more than one screen, show locations of each on sketch.