

MANCOCK  
- D20  
3-11-71

MISSISSIPPI  
 BOARD OF WATER COMMISSIONERS  
 416 North State Street  
 Jackson, Mississippi 39201

**CODED**

WATER WELL DRILLERS LOG

Mar 11 19 71 S+S. Well Works Hercock  
 date well completed firm name county well located

LANDOWNER: Sheeman Padgett  
pt 1,  
Doss Christian  
 (mailing address)

Description of formations encountered	from	to
<u>top soil</u>	<u>0</u>	<u>3</u>
<u>clay</u>	<u>3</u>	<u>30</u>
<u>sand</u>	<u>30</u>	<u>50</u>

WELL LOCATION:  
 sec 4 T 6 N R 14 E  
2 miles N of Standard  
 (distance) (direction) (nearest town)

WELL PURPOSE: Home  
 (home, irrigation, municipal, industrial)

- WELL COMPLETION DATA:
- (1) diameter (inches) 2
  - (2) total depth (feet) 50'
  - (3) static water level (feet) 40 below above top of ground
  - (4) casing P.V.C., 40'  
(material) (depth)  
2" if telescope see back.  
(size)
  - (5) screen 10', 40'  
(length) (depth to top)  
2", P.V.C.  
(size) (material)
  - (6) pump 1, 4  
(HP) (yield gpm)  
EC  
(type power)
  - (7) electric log No  
(yes or no)

**CODED**

(organization running log)

MAR 13 1971


(8) how well bottom plugged D.W.

DRILLERS REMARKS:  
Doss

MISS. BD. OF  
 WATER COMM.

If well telescopes please sketch and show depths.

GROUND LEVEL

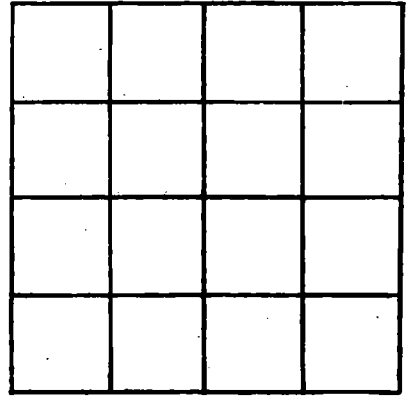

SECTION \_\_\_\_\_

Please indicate well location X.

ADDITIONAL INFORMATION

If more than one screen, show locations of each on sketch.