

HANCOCK  
D 21  
3-2-71

MISSISSIPPI  
 BOARD OF WATER COMMISSIONERS  
 416 North State Street  
 Jackson, Mississippi 39201

**CODED**

WATER WELL DRILLERS LOG

3-2 1971 Lenton Well Serv Hancock  
 date well completed firm name county well located

LANDOWNER: Sidney Carriga  
Rt. 2 Box 345  
Pass Christian Miss  
 (mailing address)

description of formations encountered	from	to
Surface Clay	0	18
Sand	18	22
White Clay	22	46
Black Mud	46	54
Blue Clay	54	272
SAND	272	315

WELL LOCATION:  
 sec. 35 T. 6 S. R. 14 E. W  
4 miles East of Fonton  
 (distance) (direction) (nearest town)

WELL PURPOSE: Home  
 (home, irrigation, municipal, industrial)

WELL COMPLETION DATA:

(1) diameter (inches) 2 1/2

(2) total depth (feet) 315

(3) static water level (feet) 62 below top of ground.

(4) casing Galv, 305  
 (material) (depth)  
2 if telescope see back.  
 (size)

(5) screen 10', 305  
 (length) (depth to top)  
2, S. Steel  
 (size) (material)

(6) pump 1, 6  
 (HP) (yield gpm)  
Elec  
 (type power)

(7) electric log NO  
 (yes or no)

(organization running log)

**CODED**

(8) how well bottom plugged Ball Valve


MAR 25 1971

DRILLERS REMARKS:

MISS. BD. OF  
 WATER COMM.

If well telescopes please sketch and show depths.

GROUND LEVEL

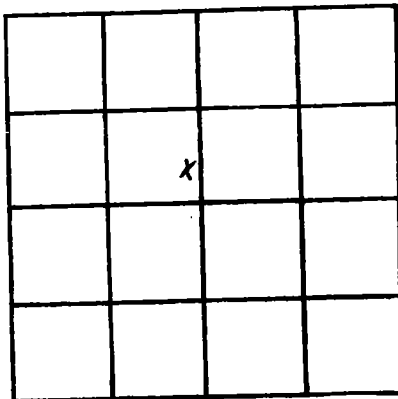

SECTION 35

Please indicate well location X.

**ADDITIONAL INFORMATION**

If more than one screen, show locations of each on sketch.