

HANCOCK
D23
4-20-71

MISSISSIPPI
 BOARD OF WATER COMMISSIONERS
 416 North State Street
 Jackson, Mississippi 39201

CODED

WATER WELL DRILLERS LOG

4-20 1971 Porton Well Serv HANCOCK
 date well completed firm name county well located

LANDOWNER: Merlin Peterson
Rt. 1 Box 217 A
Pass Christian Miss.
 (mailing address)

description of formations encountered	from	to
	Surface clay	0
Gravel	32	54
White clay	54	85
Blue clay	85	325
Sand	325	362

WELL LOCATION:
 sec. 12 T. 6 S. R. 14 W.
2 miles S East of Standard
 (distance) (direction) (nearest town)

WELL PURPOSE: Home
 (home, irrigation, municipal, industrial)

- WELL COMPLETION DATA:
- diameter (inches) 2
 - total depth (feet) 362
 - static water level (feet) 91 below
 top of ground.
 - casing Galv, 357,
 (material) (depth)
2 if telescope see back.
 (size)
 - screen 5, 357
 (length) (depth to top)
2, S. steel
 (size) (material)
 - pump 1, 6
 (HP) (yield gpm)
Elec
 (type power)
 - electric log NO
 (yes or no)
- (organization running log)
- (8) how well bottom plugged Bad Value

CODED


MAY 13 1971

DRILLERS REMARKS:

MISS. BD. OF
 WATER COMM.

If well telescopes please sketch and show depths.

GROUND LEVEL

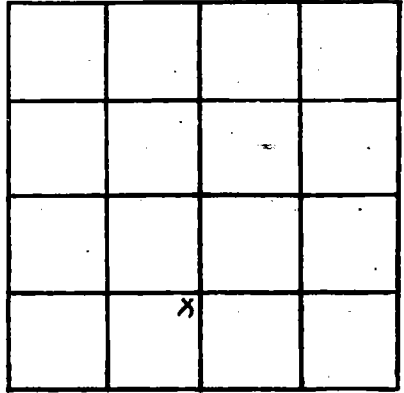

SECTION 12

Please indicate well location X.

ADDITIONAL INFORMATION

If more than one screen,
show locations of each on sketch.