

HANCOCK
D24
7-18-60

WATER WELL DRILLERS LOG

CODED 21-301

Date: 7-18, 1960, Driller: Pennington County Hancock
(Name)

(1) Owner of Land: Miss Mrs Weston Ladner
(Name)
RT 1 Bx 199 Caro Christian
(Address)

(2) Location: NW 1/4, RW 1/4, Sec. 4 T6 R14
(distance) miles (direction) of (Nearest Town)

(3) Topography: (Hilly) (Flat) (Level)

(4) Purpose of Well: Home use
(Domestic Irrigation
Municipal, Industrial, Other)

Description & Color of Materials Sand, Clay, Red Clay, Shell, etc.	Thick- ness Feet	Depth Feet
<u>Red Sand + Mud</u>	<u>168</u>	
<u>Blue Mud Shells</u>	<u>60 40</u>	
<u>Total Dept.</u>		<u>275</u>

Information upon completion of well:


- (1) Diameter 2" x 1/4" inches.
- (2) Total Depth 275 feet.
- (3) Water Level 88 ft feet below top of ground.
- (4) Cased to _____, Size _____
- (5) Screen: Size 1/4, Length 10 ft
- (6) Were any formations sealed against pollution?
_____ yes, _____ no.

If YES depth of formation _____

Why _____

Drillers Remarks: _____

CODED

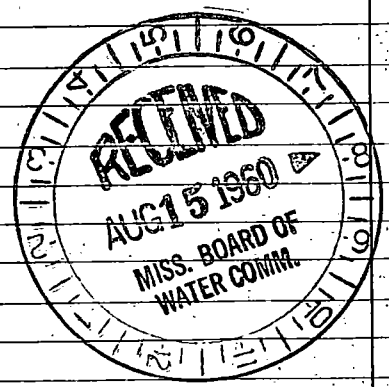

(Use Back Side)

Well No.

1940

Monday, January 1st, 1940

Clear, cold. Windy. Snow on hills.

1	10
2	10
3	10
4	10
5	10
6	10
7	10
8	10
9	10
10	10

1	10
2	10
3	10
4	10
5	10
6	10
7	10
8	10
9	10
10	10

Clear, cold. Windy. Snow on hills.