

025
7-24-60

WATER WELL DRILLERS LOG

302
CODED

Date: 7-24, 1960, Driller: Jens of Bell County Hancock
(Name)

(1) Owner of Land: Charlie Hoda
(Name)

(Address)

(2) Location: 7NW 1/4, SE 1/4, Sec 30 T6 R14

6 miles North of Wibaux
(distance) (direction) (Nearest Town)

(3) Topography: (Hilly) (Flat) (Level)

(4) Purpose of Well: Home use
(Domestic Irrigation, Municipal, Industrial, Other)

Description & Color of Materials Sand, Clay, Red Clay, Shell, etc.	Thick- ness Feet	Depth Feet
<u>Red mud</u>	<u>101</u>	
<u>Blue Clay</u>	<u>46</u>	
<u>water strata</u>	<u>39</u>	
		<u>186</u>

Information upon completion of well:

- (1) Diameter 2" inches.
- (2) Total Depth 186 feet.
- (3) Water Level 25' feet below top of ground.
- (4) Cased to _____, Size _____
- (5) Screen: Size 2", Length 10 ft
- (6) Were any formations sealed against pollution?


yes no.

If YES depth of formation Backfilled Sand

Why _____

Drillers Remarks: _____

CODED

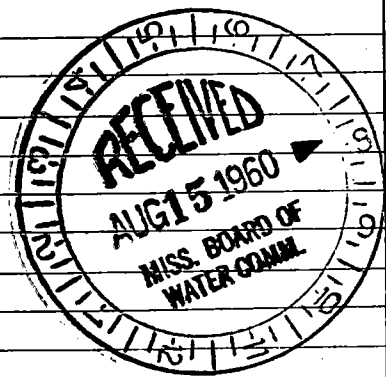

(Use Back Side)

Well No.

