

HANCOCK
D28

MISSISSIPPI BOARD OF WATER COMMISSIONERS

12-7-60

WATER WELL DRILLERS LOG

CODED 04

Date: 12-7, 1960, Driller: J B

County Hancock

(Name)

(1) Owner of Land: Bolin Sabred
(Name)

RT-1, Box 199 Pans Christian
(Address)

(2) Location: 1/4, 1/4, Sec. 9 14 R

9 miles North, of Urbn
(distance) (direction) (Nearest Town)

(3) Topography: Highway 603
(Hilly) (Flat) (Level)

(4) Purpose of Well: Home use
(Domestic Irrigation
Municipal, Industrial, Other)

Description & Color of Materials Sand, Clay, Red Clay, Shell, etc.	Thick- ness Feet	Depth Feet
<u>First 105 ft Red Clay & Red sand</u>	<u>1</u>	<u>00'</u>
<u>Next 100 ft Blue clay</u>	<u>2</u>	<u>05'</u>
<u>240 ft fine sand</u>	<u>2</u>	<u>45'</u>
<u>Next 20 ft Blue clay</u>	<u>2</u>	<u>65'</u>
<u>Water Sand</u>	<u>31</u>	<u>96'</u>

Information upon completion of well:

(1) Diameter 2' X 1 1/4" inches.

(2) Total Depth 296 feet.

(3) Water Level 60 ft feet below top of ground.

(4) Cased to _____, Size _____

(5) Screen: Size 1 1/4, Length 10 ft


(6) Were any formations sealed against pollution?
_____ yes, _____ no.

If YES depth of formation _____

Why _____

Drillers Remarks: _____

CODED

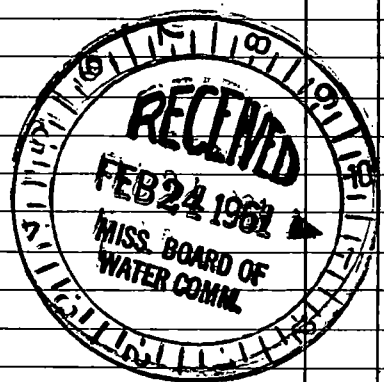

(Use Back Side)

Well No.

THE UNIVERSITY OF CHICAGO

[The remainder of the page contains extremely faint and illegible text, likely bleed-through from the reverse side of the document.]