

D29
10-31-61

WATER WELL DRILLERS LOG

6302
CODED

Date: 10-31, 1961, Driller: J. Beall County Hancock
(Name)

(1) Owner of Land: <u>Andrews, Chicago</u> (Name)	Description & Color of Materials Sand, Clay, Red Clay, Shell, etc.	Thick- ness Feet	Depth Feet
<u>RT 1 Box</u> <u>Con. Christian</u> (Address)	<u>Sand + Gravel</u>	<u>60</u>	<u>60</u>
(2) Location: <u>1/4</u> , <u>1/4</u> Sec. <u>18</u> <u>14</u> RT	<u>Soft mud</u>	<u>45</u>	<u>105</u>
<u>8</u> miles <u>North</u> of <u>Vibra</u> (distance) (direction) (Nearest Town)	<u>Hard Blue Clay</u>	<u>60</u>	<u>165</u>
(3) Topography: <input checked="" type="checkbox"/> (Hilly) <input type="checkbox"/> (Flat) <input type="checkbox"/> (Level)	<u>Fine sand</u>	<u>40</u>	<u>205</u>
(4) Purpose of Well: <u>Home</u> (Domestic Irrigation Municipal, Industrial, Other)	<u>Coarse sand</u>	<u>46</u>	<u>251</u>


Information upon completion of well:

Well

251

- (1) Diameter 2" x 1/4" inches.
- (2) Total Depth 251 feet.
- (3) Water Level 45 feet below top of ground.
- (4) Cased to _____, Size _____
- (5) Screen: Size _____, Length _____
- (6) Were any formations sealed against pollution?
_____ yes, _____ no.

CODED

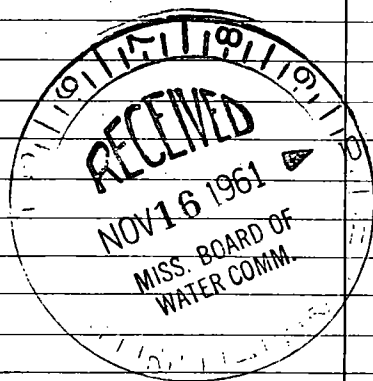

If YES depth of formation _____
Why _____
Drillers Remarks: _____

(Use Back Side)

Well No.

