

D32
9-13-63

WATER WELL DRILLERS LOG

CODED

Date: Sept 13, 1963, Driller: J. Beal County: Hancock

(Name)

(1) Owner of Land: John Flagout
(Name)
Rt 3 Pigeon
(Address)
Old Catochola school
(2) Location: 1/4, 1/4, Sec. 8, T. 6, R. 14
9 miles n, of Vilbo
(distance) (direction) (Nearest Town)


Description & Color of Materials Sand, Clay, Red Clay, Shell, etc.	Thick- ness Feet	Depth Feet
<u>Red clay</u>	<u>30</u>	<u>30</u>
<u>sand & gravel</u>	<u>45</u>	<u>75</u>
<u>Hard Blue mud</u>	<u>60</u>	<u>135</u>
<u>white sand</u>	<u>40</u>	<u>175</u>
<u>Hard Blue mud</u>	<u>105</u>	<u>280</u>
<u>strata water</u>	<u>37</u>	<u>317</u>

(3) Topography: (Hilly) (Flat) (Level)
(4) Purpose of Well: Home
(Domestic Irrigation
Municipal, Industrial, Other)

Information upon completion of well:

(1) Diameter 2"x1 1/4" inches.
(2) Total Depth 317 feet.
(3) Water Level 40 feet below top of ground.
(4) Cased to _____, Size _____
(5) Screen: Size 1/4", Length 10'.
(6) Were any formations sealed against pollution?
_____yes, _____no.

If YES depth of formation _____
Why _____
Drillers Remarks: _____

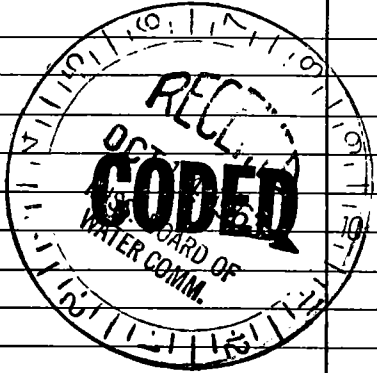

(Use Back Side)

Well No.

1910

1910