

D33

10-5-63

WATER WELL DRILLERS LOG

CODED

Date: 10-5, 1963, Driller: J. Beard County: Hancock
(Name)

(1) Owner of Land: Vernon Crow
(Name)
Rt 1 Paul Christian
(Address)

(2) Location: SE 1/4, SE 1/4, Sec. 3 T6 R14
5 miles North of Redeem
(distance) (direction) (Nearest Town)

(3) Topography: (Hilly) (Flat) (Level)

(4) Purpose of Well: Home
(Domestic Irrigation
Municipal, Industrial, Other)

Description & Color of Materials Sand, Clay, Red Clay, Shell, etc.	Thick- ness Feet	Depth Feet
<u>Red Clay + sand</u>	<u>80</u>	<u>80</u>
<u>white sand</u>	<u>70</u>	<u>150</u>
<u>Hard Blue Mud</u>	<u>100</u>	<u>250</u>
<u>Fine sand</u>	<u>30</u>	<u>280</u>
<u>water strata</u>	<u>53</u>	<u>338</u>

Information upon completion of well:

(1) Diameter 2" x 1/4" inches.

(2) Total Depth 338 feet.


(3) Water Level 104 feet below top of ground.

(4) Cased to _____, Size _____.

(5) Screen: Size 1/4", Length 15 ft.

(6) Were any formations sealed against pollution?
_____ yes, _____ no.

CODED

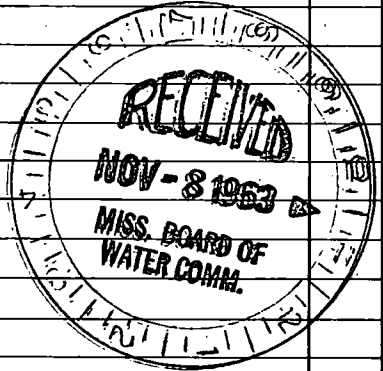

If YES depth of formation _____

Why _____

Drillers Remarks: _____

Well No.

(Use Back Side)

1943

10/1