

D36

5-25-65

WATER WELL DRILLERS LOG

CODED

Date: 5-25, 1965, Driller: Lutter Well Works County Hancock (Name)

(1) Owner of Land: Emilio Bertucci (Name) Caralia La. (Address)

(2) Location: NE 1/4, NE 1/4, Sec 21 T6SR14W, 2 miles N of Dedonville (distance) (direction) (Nearest Town)

(3) Topography: Hilly (Hilly) (Flat) (Level)

(4) Purpose of Well: domestic (Domestic Irrigation Municipal, Industrial, Other)

Table with columns: Description & Color of Materials, Thickness Feet, Depth Feet. Rows: red clay (25), sand (26), sand + gravel (8), total (59).

Information upon completion of well:


- (1) Diameter 2 inches. (2) Total Depth 59 feet. (3) Water Level 30 feet below top of ground. (4) Cased to all, Size 2". (5) Screen: Size 2", Length 5'. (6) Were any formations sealed against pollution? yes, [check] no.

If YES depth of formation

Why

Drillers Remarks:

CODED

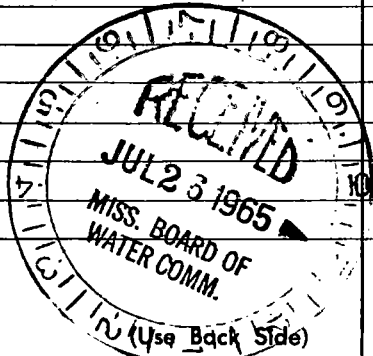

Well No.

Handwritten notes at the top of the page, including the number "24" and some illegible text.

Main body of handwritten text, appearing to be a list or series of notes, with some lines starting with "1." and "2.".

Bottom section of handwritten text, including a large, faint diagram or sketch on the left side and more notes on the right.