

HANCOCK

D 39

6-16-71

MISSISSIPPI  
 BOARD OF WATER COMMISSIONERS  
 416 North State Street  
 Jackson, Mississippi 39201

**CODED**

WATER WELL DRILLERS LOG

June 16 1971

W & S

Hancock

date well completed

firm name

county well located

LANDOWNER:

Wenell Gode

description of formations encountered

from

to

RT 1

Pass Christian  
(mailing address)

Top Soil  
Clay  
Sand

0 3  
3 30  
30 58

WELL LOCATION:

sec. 2 T 6 N R 14 E

0 miles of Starkub  
(distance) (direction) (nearest town)

WELL PURPOSE:

Home

(home, irrigation, municipal, industrial)

WELL COMPLETION DATA:

- (1) diameter (inches) 2"
- (2) total depth (feet) 58'
- (3) static water level (feet) 28' below top of ground.

- (4) casing PVC 1 1/2" (material), 48' (depth)
- 2" (size) if telescope see back.

- (5) screen 10' 48" (length), (depth to top)
- 2" (size), PVC (material)

- (6) pump 1 (HP), 4 (yield gpm)
- 6 (type power)

- (7) electric log No (yes or no)

(organization running log)

- (8) how well bottom plugged BW

**CODED**


DRILLERS REMARKS:

JUN 22 1971

MISS. BD. WATER

If well telescopes please sketch and show depths.

GROUND LEVEL

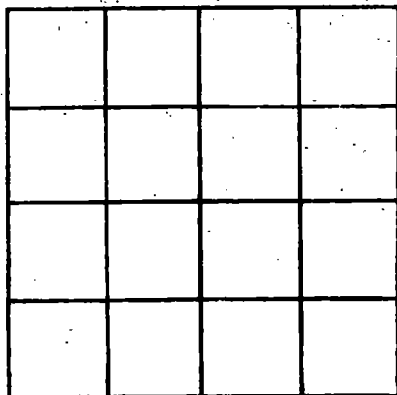

SECTION \_\_\_\_\_

Please indicate well location X.

ADDITIONAL INFORMATION

If more than one screen, show locations of each on sketch.