

Hancock
D-42
3-29-71

MISSISSIPPI
BOARD OF WATER COMMISSIONERS
416 North State Street
Jackson, Mississippi 39201

WATER WELL DRILLERS LOG

CODED

March 29 1971 ~~1971~~ M & W Drilling Co Hancock
date well completed firm name county well located

LANDOWNER: Arthur Powell
Rt. 1
Pass Christian, Miss.
(mailing address)

description of formations encountered	from	to
CLAY	0	20
SAND	20	35
CLAY	35	55
SAND	55	90
Blue CLAY	90	165
SAND	165	200

WELL LOCATION:
sec 28 T-6 N R-14 E
(S) (W)
2.5 miles N of Pass Christian
(distance) (direction) (nearest town)

WELL PURPOSE: HOME
(home, irrigation, municipal, industrial)

- WELL COMPLETION DATA:
- (1) diameter (inches) 2"
 - (2) total depth (feet) 200
 - (3) static water level (feet) 30 ^(below) _(above) top of ground.
 - (4) casing 2" galv. ~~1 1/2"~~ 190'
(material) (depth)
 - (size) if telescope see back.
 - (5) screen 10' (length) (depth to top)
8 # stainless steel
(size) (material)
 - (6) pump 1 (HP) 9 (yield gpm)
elec
(type power)
 - (7) electric log no (yes or no)
n/a
(organization running log)
 - (8) how well bottom plugged
BACK WASH VALVE

CODED


SEP 16 1971

DRILLERS REMARKS:

MISS. BD. OF
WATER COMM.

If well telescopes please sketch and show depths.

GROUND LEVEL

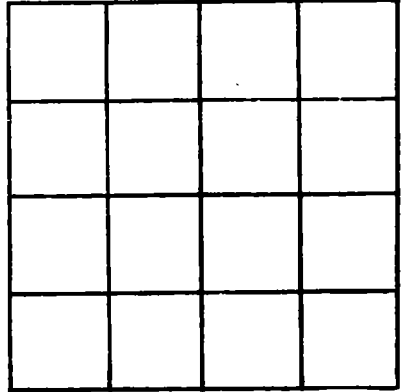

SECTION 28

Please indicate well location X.

ADDITIONAL INFORMATION

If more than one screen, show locations of each on sketch.