

HANCOCK
D45
10-28-71

MISSISSIPPI
 BOARD OF WATER COMMISSIONERS
 416 North State Street
 Jackson, Mississippi 3920

NOV 22 1971

CODED
 DIVISION OF
 WATER CONTROL

WATER WELL DRILLERS LOG

Oct 28 1971 S. S. Well works Hancock
 date well completed firm name county well located


LANDOWNER: <u>Les Swilley</u> <u>Rt. 1 Passchrista</u> <u>Miss -</u> (mailing address)	description of formations encountered	from	to
	<u>top sand</u>	<u>0</u>	<u>2</u>
	<u>sand</u>	<u>2</u>	<u>26</u>
WELL LOCATION: <u>sec 4 T 6 N</u> <u>R 14 E</u> <u>S W</u> miles of (distance) (direction) (nearest town)			
WELL PURPOSE: <u>Home</u> (home, irrigation, municipal, industrial)			
WELL COMPLETION DATA:			
(1) diameter (inches) <u>2 in.</u>			
(2) total depth (feet) <u>26</u>			
(3) static water level (feet) <u>16</u> below above top of ground.			
(4) casing <u>PVC</u> , <u>21</u> , (material) (depth)			
<u>2</u> If telescope see back. (size)			
(5) screen <u>5</u> , <u>21</u> (length) (depth to top)			
<u>2</u> , <u>PVC</u> (size) (material)			
(6) pump <u>1/2</u> <u>2</u> (HP) (yield gpm)			
<u>E</u> (type power)			
(7) electric log _____ (yes or no)			
_____ (organization running log)			
(8) how well bottom plugged <u>B.W.</u>			
DRILLERS REMARKS: <u>none</u>			

CODED

If well telescopes please sketch and show depths.




GROUND LEVEL

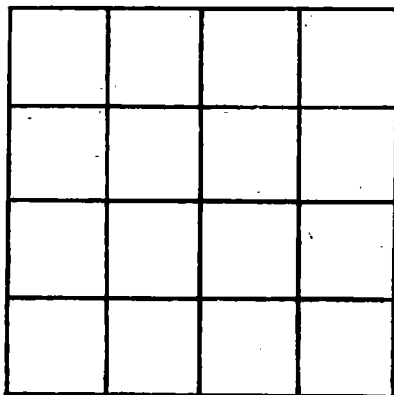

SECTION _____

Please indicate well location X.

ADDITIONAL INFORMATION

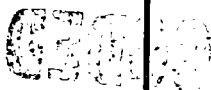

If more than one screen, show locations of each on sketch.