

HANCOCK
D 49
5-24-73

MISSISSIPPI
 BOARD OF WATER COMMISSIONERS
 416 North State Street
 Jackson, Mississippi 39201

CODED

WATER WELL DRILLERS LOG

5-24-73 19
 date well completed

T. T. WARD WATER WELLS
 firm name

HANCOCK
 county well located

LANDOWNER: CLYDE CRAIG

description of formations encountered

from to

HWY. 603

clay

0 21

RAY ST. LOUIS, MISS.
 (mailing address)

clay silt
concl - 2nd

21 36

36 215

215 304

WELL LOCATION:

sec 18 T 6 N R 14 E
18 miles N of B.S.L.
 (distance) (direction) (nearest town)

WELL PURPOSE: HOME
 (home, irrigation, municipal, industrial)

CODED

WELL COMPLETION DATA:


- (1) diameter (inches) 2"
- (2) total depth (feet) 304'
- (3) static water level (feet) 85 ^{below} above top of ground.
- (4) casing 2" GALV, 294'
 (material) (depth)
 (size) if telescope see back.
- (5) screen 10', -
 (length) (depth to top)
2", S.S.
 (size) (material)
- (6) pump 1, 8
 (HP) (yield gpm)
Elec.
 (type power)
- (7) electric log NO
 (yes or no)
N/A
 (organization running log)
- (8) how well bottom plugged BWU

DRILLERS REMARKS: N/A

JUN 25 1973

If well telescopes please sketch and show depths.

GROUND LEVEL

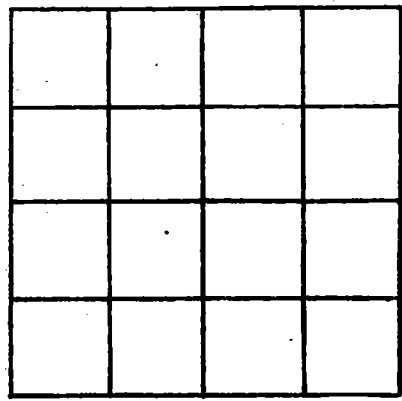

SECTION 18

Please indicate well location X.

ADDITIONAL INFORMATION

If more than one screen, show locations of each on sketch.