

**HANCOCK**  
**DSI**  
**12-12-73**

*Walter Penton*

MISSISSIPPI  
 BOARD OF WATER COMMISSIONERS  
 416 North State Street  
 Jackson, Mississippi 39201

CODED

WATER WELL DRILLERS LOG

12-12 1973 Penton Well Serv Hancock  
 date well completed firm name county well located

LANDOWNER: Kermit Ladner  
Pt. 2 Box 348  
Pass Christian Miss  
 (mailing address)

description of formations encountered	from	to
<u>Surface Clay</u>	<u>0</u>	<u>40</u>
<u>Red Sand</u>	<u>40</u>	<u>150</u>
<u>Blue Clay</u>	<u>150</u>	<u>340</u>
<u>Sand</u>	<u>340</u>	<u>406</u>

WELL LOCATION:  
 sec. 35 T. 6 S. R. 14 W.  
4 miles North of Penton  
 (distance) (direction) (nearest town)

WELL PURPOSE: Home  
 (home, irrigation, municipal, industrial)

WELL COMPLETION DATA:

(1) diameter (inches) 2

(2) total depth (feet) 406

(3) static water level (feet) 69 below top of ground.

(4) casing Cole - 396  
 (material) (depth)

2 if telescope see back.  
 (size)

(5) screen 10 396  
 (length) (depth to top)

2 S. Steel  
 (size) (material)

(6) pump 1 9  
 (HP) (yield gpm)


Elec  
 (type power)

(7) electric log No  
 (yes or no)

(organization running log)

(8) how well bottom plugged B.W. Value

CODED

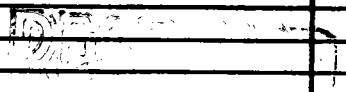

DEC 16 1973

DRILLERS REMARKS:

WATER COMMISSION

If well telescopes please sketch and show depths.

GROUND LEVEL

			X
			o

SECTION 35

Please indicate well location X.

ADDITIONAL INFORMATION

If more than one screen, show locations of each on sketch.