

HANCOCK
D52
8/20/74

MISSISSIPPI
 BOARD OF WATER COMMISSIONERS
 416 North State Street
 Jackson, Mississippi 39201

CODED

WATER WELL DRILLERS LOG

8-20-74
 date well completed

19 R. J. Moore
 firm name

HANCOCK
 county well located

LANDOWNER: Cl. Orey
RT 1 Box 567
PASS CHRISTIAN, MISS
 (mailing address)

description of formations encountered	depth	
	from	to
TOP SOIL	0	10
Red CLAY	10	30
Red Sand	30	70
Blue CLAY	70	340
Coarse Gravel Sand	340	380

WELL LOCATION:
 sec. 14 T. 6 N. R. 14 E.
10 miles N of PASS CHRISTIAN
 (distance) (direction) (nearest town)

WELL PURPOSE:
 (home, irrigation, municipal, industrial)

WELL COMPLETION DATA:

(1) diameter (inches) 2"

(2) total depth (feet) 380'

(3) static water level (feet) 120 below above top of ground.

(4) casing PVC 370'
 (material) (depth)
 (size) If telescope see back.

(5) screen 10' 370'
 (length) (depth to top)
2" PVC
 (size) (material)

(6) pump 1 1/2 5
 (HP) (yield gpm)
8
 (type power)

(7) electric log _____
 (yes or no)
 (organization running log)

(8) how well bottom plugged 13" pipe


CODED

DRILLERS REMARKS:

MISSISSIPPI WATER CONTROL

If well telescopes please sketch and show depths.

GROUND LEVEL

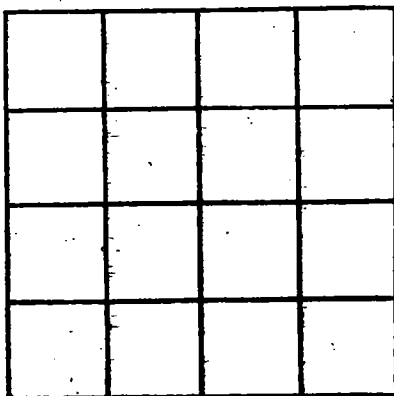

SECTION _____

Please indicate well location X.

ADDITIONAL INFORMATION

If more than one screen, show locations of each on sketch.