

HANCOCK  
D53  
5-25-74

MISSISSIPPI  
BOARD OF WATER COMMISSIONERS  
416 North State Street  
Jackson, Mississippi 39201

**CODED**

WATER WELL DRILLERS LOG

5-25 1974 Bob Peterson & Son Hancock  
date well completed firm name county well located

LANDOWNER: Ray Anderson  
Kiln Miss.

description of formations encountered	from	to
<u>White Shale</u>	<u>0</u>	<u>42</u>
<u>White sand</u>	<u>42</u>	<u>175</u>
<u>Blue shale</u>	<u>175</u>	<u>280</u>
<u>Blue sand</u>	<u>280</u>	<u>320</u>
<u>Blue shale</u>	<u>320</u>	<u>460</u>
<u>Gray sand &amp; rock</u>	<u>460</u>	<u>510</u>

(mailing address)

WELL LOCATION:  
sec. 26 T. 6 N. R. 14 E  
8 miles NE of Kiln  
(distance) (direction) (nearest town)

WELL PURPOSE: Home  
(home, irrigation, municipal, industrial)

WELL COMPLETION DATA:

(1) diameter (inches) 2 in

(2) total depth (feet) 510

(3) static water level (feet) 9 ft below top of ground

(4) casing Galv. 490  
(material) (depth)

(size) If telescope see back.

(5) screen 2x20, 490  
(length) (depth to top)

2x20, S.S. 120-12  
(size) (material)

(6) pump \_\_\_\_\_ (HP) \_\_\_\_\_ (yield gpm)

No  
(type power)

(7) electric log \_\_\_\_\_ (yes or no)

\_\_\_\_\_  
(organization running log)

**CODED**

(8) how well bottom plugged  
Good Shale


DRILLERS REMARKS:

**RECEIVED**

OCT - 5 1974

If well telescopes please sketch and show depths.

GROUND LEVEL

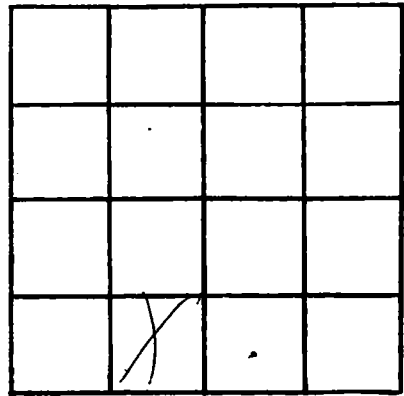

SECTION \_\_\_\_\_

Please indicate well location X.

ADDITIONAL INFORMATION

If more than one screen,  
show locations of each on sketch.