

Hancock  
 D 55  
 7/27/75

MISSISSIPPI  
 BOARD OF WATER COMMISSIONERS  
 416 North State Street  
 Jackson, Mississippi 39201

CODED

WATER WELL DRILLERS LOG

7/27 1974 Grull Water Well Hancock  
 date well completed firm name county well located


LANDOWNER: <u>Valone Sadne</u>	description of formations encountered	from	to
<u>Kiln Miss</u>			
(mailing address)	<u>red clay</u>	<u>6</u>	<u>90'</u>
WELL LOCATION: sec. <u>19</u> T. <u>6</u> N. R. <u>14</u> E. <u>B35</u> <u>6</u> miles <u>North</u> of <u>Kiln</u> (distance) (direction) (nearest town)	<u>white clay</u>	<u>90</u>	<u>153</u>
WELL PURPOSE: <u>home</u> (home, irrigation, municipal, industrial)	<u>blue clay</u>	<u>153</u>	<u>230</u>
WELL COMPLETION DATA: (1) diameter (inches) <u>2"</u>	<u>Water sand</u>	<u>230</u>	<u>253</u>
(2) total depth (feet) <u>253</u>			
(3) static water level (feet) <u>40</u> below top of ground.			
(4) casing <u>PVC</u> , <u>243</u> (material) (depth) <u>2"</u> (size) If telescope see back.			
(5) screen <u>10</u> , <u>243</u> (length) (depth to top) <u>2</u> , <u>PVC Johnson</u> (size) (material)			
(6) pump <u>1</u> , <u>90</u> (HP) (yield gpm) <u>E/</u> (type/power)			
(7) electric log <u>Y</u> (yes or no) <u>Y/</u> (organization running log)			
(8) how well bottom plugged <u>and</u> <u>shank</u>			

RECORDED  
 SEP 19 1975

DRILLERS REMARKS: \_\_\_\_\_  
 MISS. BD. OF WATER COMM.

If well telescopes please sketch and show depths.

GROUND LEVEL

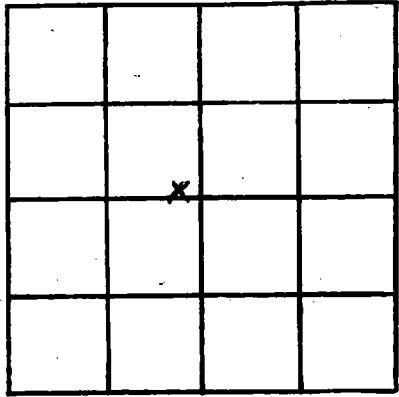

SECTION 18

Please indicate well location X.

ADDITIONAL INFORMATION

If more than one screen, show locations of each on sketch.