

HANCOCK  
 D61  
 3-16-79

MISSISSIPPI  
 BOARD OF WATER COMMISSIONERS  
 416 North State Street  
 Jackson, Mississippi 39201

CODED

WATER WELL DRILLERS LOG

3-16-79 date well completed  
 Turner Drilling firm name  
 Hancock county well located

LANDOWNER:	description of formations encountered	from	to
Upton Oil of California Suite 325 Cottage Hill Rd. Mobile, Alabama (mailing address)	clay	0	10
	sand	10	70
	clay	70	105
WELL LOCATION: 1980'S + 1980'E sec. 16 T-6 N R-14 E of N miles 10 of (direction) (nearest town)	sand	105	156
	clay	156	199
	sand	199	220
	clay	220	242
WELL PURPOSE: (home, irrigation, municipal, industrial)	sand-clay	242	294
	sand	294	315
	sand + clay	315	357
WELL COMPLETION DATA: (1) diameter (inches) - 3" (2) total depth (feet) - 357' (3) static water level (feet) 65' (flow above top of ground) (4) casing steel, 357' (material) (depth) 3" (size) If telescope see back. (5) screen 42' 315' (length) (depth to top) 3" (size) perforated (material) (6) pump 70 (HP) (yield gpm) AC (type power) (7) electric log (yes or no) (organization running log) (8) how well bottom plugged orange pill			
DRILLERS REMARKS:			

CODED


Miss. Board of Water Comm. 3

MAR 28 1979

RECEIVED

If well telescopes please  
sketch and show depths.

GROUND LEVEL

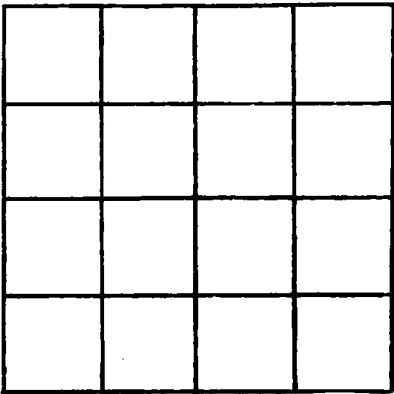

SECTION \_\_\_\_\_

Please indicate well location X.

ADDITIONAL INFORMATION

If more than one screen,  
show locations of each on sketch.